


BOLIVAR MISSISSIPPI BOARD OF WATER COMMISSIONERS

G 78 *91*
6-23-63

WATER WELL DRILLERS LOG *7/25/63* **CODED**

Date: June 23, 1963, Driller: Layne-Central Company County Bolivar
(Name)

(1) Owner of Land: <u>Rayner Hardware Co.</u> (Name)	Description & Color of Materials Sand, Clay, Red Clay, Shell, etc.	Thick- ness Feet	Depth Feet
<u>Merigold, Mississippi</u> (Address)	Clay	14	14
	Coarse sand	21	35
(2) Location: <u>1/4, 1/4, Sec. 4</u> <u>T23N</u> <u>R6W</u>	Coarse sand, sand, clay		
<u>_____</u> miles <u>west</u> of <u>Merigold</u>	balls	5	40
(distance) (direction) (Nearest Town)	Coarse sand, sand, pea		
(3) Topography: <u>flat</u>	gravel	62	102
(Hilly) (Flat) (Level)			
(4) Purpose of Well: <u>irrigation</u>			
(Domestic Irrigation Municipal, Industrial, Other)			
Information upon completion of well:			
(1) Diameter <u>12</u> inches.			
(2) Total Depth <u>102</u> feet.			
(3) Water Level <u>21' - 6"</u> feet below top of ground.			
(4) Cased to <u>67'</u> , Size <u>12"</u>			
(5) Screen: Size <u>12"</u> , Length <u>35'</u>			
(6) Were any formations sealed against pollution?			
<u>_____</u> yes, <u>no</u> no.			
If YES depth of formation _____			
Why _____			
Drillers Remarks: _____			

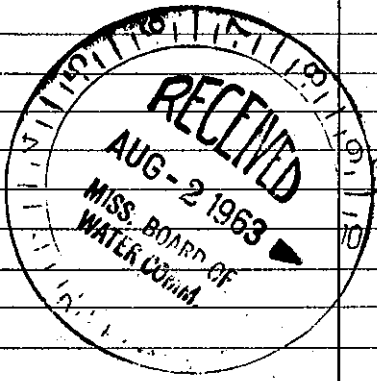

Well No.

(Use Back Side)

Mail this copy to Board of Water Commissioners 429 Miss. St. Jackson, Mis