

Bolivar MISSISSIPPI BOARD OF WATER COMMISSIONERS

G 94

7-22-66 CODED WATER WELL DRILLERS LOG

CODED

Date: 7/22, 1966, Driller: Delta Well Supply County Bolivar  
(Name)

(1) Owner of Land	Description & Color of Materials Sand, Clay, Red Clay, Shell, etc.	Thick- ness Feet	Depth Feet
<u>J. C. Horvath Jr.</u> (Name)	<u>Top soil</u>	<u>22</u>	
<u>R. F. Cleveland, Miss.</u> (Address)	<u>Fine sand &amp; clay</u>	<u>20</u>	<u>42</u>
(2) Location: <u>50. cents</u> <u>23 6</u> <u>1/4</u> , <u>1/4</u> , Sec. <u>7</u> T <u>1</u> R <u>W</u>	<u>u</u>	<u>10</u>	<u>52</u>
<u>4</u> miles <u>NE</u> of <u>Place</u> (distance) (direction) (Nearest Town)	<u>Sand Med.</u>	<u>8</u>	<u>60</u>
(3) Topography: _____ (Hilly) (Flat) (Level)	<u>u + gravel</u>	<u>50</u>	<u>110</u>
(4) Purpose of Well: <u>Irrigation</u> (Domestic Irrigation Municipal, Industrial, Other)			

CODED


Information upon completion of well:

- (1) Diameter 16 inches.
- (2) Total Depth 110 feet.
- (3) Water Level 21 feet below top of ground.
- (4) Cased to 70, Size 16
- (5) Screen: Size 16, Length 40
- (6) Were any formations sealed against pollution?  
\_\_\_\_\_ yes,  no.

If YES depth of formation \_\_\_\_\_

Why \_\_\_\_\_

Drillers Remarks: \_\_\_\_\_

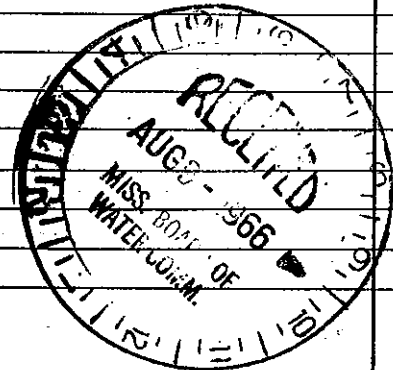

Well No. \_\_\_\_\_

Mail this copy to Board of Water Commissioners 429 Miss. St. Jackson, Miss: