

*Boliver* MISSISSIPPI BOARD OF WATER COMMISSIONERS

*G 95*  
8-2-66

**WATER WELL DRILLERS LOG**

Date: *8/2*, 19*66*, Driller: *Dallas Doble Supply* County: *Boliver*  
(Name)

(1) Owner of Land: *E. D. Rayner*  
(Name)  
*Merigold*  
(Address)  
*north* *236*  
(2) Location:  $\frac{1}{4}$ ,  $\frac{1}{4}$ , Sec. *9* T. *N.R.W.*  
*5* miles *North* of *Merigold*  
(distance) (direction) (Nearest Town)  
(3) Topography:  (Hilly)  (Flat)  (Level)  
(4) Purpose of Well: *Irrigation*  
(Domestic, Irrigation, Municipal, Industrial, Other)


Description & Color of Materials Sand, Clay, Red Clay, Shell, etc.	Thick- ness Feet	Depth Feet
<i>Soft white clay</i>	<i>23</i>	
<i>Sand &amp; W</i>	<i>22</i>	<i>45</i>
<i>11 Fine</i>	<i>18</i>	<i>63</i>
<i>11 coarse gravel</i>	<i>40</i>	<i>103</i>

CODED

Information upon completion of well:

(1) Diameter *12* inches.  
(2) Total Depth *103.5* feet.  
(3) Water Level *22* feet below top of ground.  
(4) Cased to *73*, Size *12*  
(5) Screen: Size *12*, Length *30*  
(6) Were any formations sealed against pollution?  
 yes,  no.

If YES depth of formation \_\_\_\_\_  
Why \_\_\_\_\_  
Drillers Remarks: \_\_\_\_\_

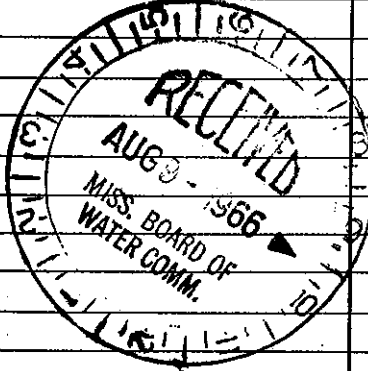

Well No.

(Use Back Side)

Mail this copy to Board of Water Commissioners 429 Miss. St. Jackson, Miss.