

Bolivar MISSISSIPPI BOARD OF WATER COMMISSIONERS

G 96
11-66

CODED WATER WELL DRILLERS LOG


CODED

Date: 11-3, 1966, Driller: Butane Gas Co. County: Bolivar

(Name)

(1) Owner of Land: <u>Donald Kitchens</u> (Name)	Description & Color of Materials Sand, Clay, Red Clay, Shell, etc.	Thick- ness Feet	Depth Feet
<u>Merigold, Miss.</u> (Address)	Clay	13	13
(2) Location: <u>NW 1/4, NW 1/4, Sec. 14 T23R6W</u>	Sand	41	54
<u>4</u> miles <u>W</u> , of <u>Merigold</u> (distance) (direction) (Nearest Town)	Sand + Gravel	75	129
(3) Topography: <input checked="" type="checkbox"/> (Hilly) <input type="checkbox"/> (Flat) <input type="checkbox"/> (Level)	Clay	40	169
(4) Purpose of Well: <u>Domestic</u> (Domestic Irrigation Municipal, Industrial, Other)	Clay + Sand Streaks	106	275
Information upon completion of well:	Sand	57	332
(1) Diameter <u>4 3/4</u> inches.	Brown Shale	5	337
(2) Total Depth <u>790</u> feet.	Sand + Shale	191	528
(3) Water Level <u>23' 7"</u> feet below top of ground.	Shale	54	582
(4) Cased to <u>776</u> , Size <u>4" x 2"</u>	Sand	24	606
(5) Screen: Size <u>2</u> , Length <u>20'</u>	Stummy Shale	97	703
(6) Were any formations sealed against pollution?	Sand	87	790
_____ yes, <input checked="" type="checkbox"/> no.			
If YES depth of formation _____			
Why _____			
Drillers Remarks: _____			

CODED

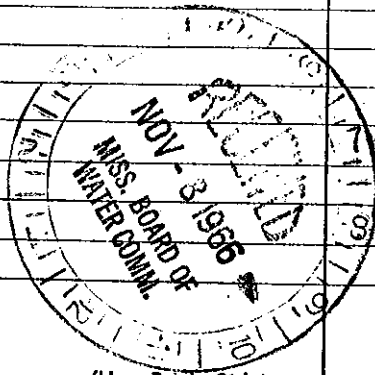

Well No.

(Use Back Side)

Retain this copy for your office files.