

Bolivar

MISSISSIPPI BOARD OF WATER COMMISSIONERS

G 97
11-66

CODED
WATER WELL DRILLERS LOG

CODED

Date: 11-9, 1966, Driller: Five County Junction County Bolivar
(Name)

(1) Owner of Land: LAURENCE MURPHY
(Name)
Box 307 Pace Miss
(Address)

(2) Location: SW 1/4, NE 1/4, Sec. 32 T. 23N R. 6W
1/4 miles NE of PACE
(distance) (direction) (Nearest Town)

(3) Topography: flat
(Hilly) (Flat) (Level)

(4) Purpose of Well: Irrigation
(Domestic Irrigation
Municipal, Industrial, Other)

Description & Color of Materials Sand, Clay, Red Clay, Shell, etc.	Thick- ness Feet	Depth Feet
<u>Clay.</u>		<u>20 1/2</u>
<u>Clay & Sand</u>	<u>6 1/2</u>	<u>27</u>
<u>Sand & Gravel</u>	<u>73</u>	<u>100</u>
<u>Rock @ 100'</u>		

CODED

Information upon completion of well:

(1) Diameter 6 inches.

(2) Total Depth 100 feet.

(3) Water Level 19' 6" feet below top of ground.

(4) Cased to 52', Size 6"


(5) Screen: Size 6", Length 48"

(6) Were any formations sealed against pollution?
_____ yes, no.

If YES depth of formation _____

Why _____

Drillers Remarks: _____

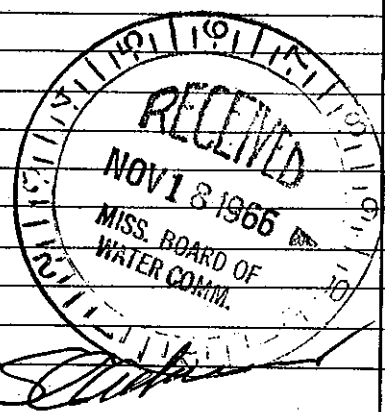

Well No.

(Use Back Side)

Mail this copy to Board of Water Commissioners 429 Miss. St. Jackson, Miss.