

Bolivar  
G 99  
3-67

CODED CODED

MISSISSIPPI  
 BOARD OF WATER COMMISSIONERS  
 416 North State Street  
 Jackson, Mississippi 39201

*3/22/67*  
*2392*

WATER WELL DRILLERS LOG

March 5, 19 67 Layne-Central Company Bolivar  
 date well completed firm name county well located

LANDOWNER: Hall Farms  
Cleveland, Mississippi  
 (mailing address)  
 WELL LOCATION:  
 sec. 20 T. 23 N R. 6 E  
 S W  
4 miles north of Face  
 (distance) (direction) (nearest town)


description of formations encountered	from	to
Clay	0	16
Coarse sand	16	35
Coarse sand, pea gravel, lignite	35	75
Coarse sand, pea gravel	75	112

WELL PURPOSE: irrigation  
 (home, irrigation, municipal, industrial)

CODED

WELL COMPLETION DATA:

- (1) diameter (inches) 12
- (2) total depth (feet) 112
- (3) static water level (feet) 21 1/2 above top of ground.
- (4) casing steel 62'  
 (material) (depth)  
12" If telescope see back.  
 (size)
- (5) screen 50' 112'  
 (length) (depth to top)  
12" Armco  
 (size) (material)
- (6) pump 25 1500  
 (HP) (yield gpm)  
Elec  
 (type power)
- (7) electric log no  
 (yes or no)  
 (organization running log)
- (8) how well bottom plugged plate

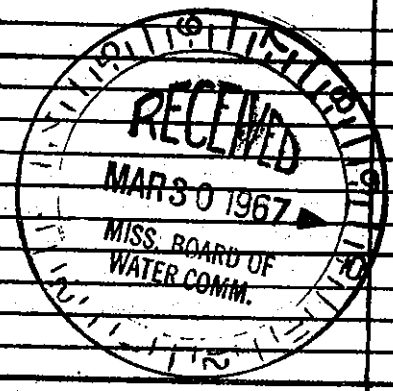

DRILLERS REMARKS: