

CODED

CODED

4/14/67  
C2422

Bolivar  
G 100  
4-67

MISSISSIPPI  
BOARD OF WATER COMMISSIONERS  
416 North State Street  
Jackson, Mississippi 39201  
WATER WELL DRILLERS LOG

April 3, 1967 Layne-Central Company Bolivar  
date well completed firm name county well located

LANDOWNER: Robert E. Smith

description of formations encountered

from to

Clay	0	21
Coarse sand	21	55
Coarse sand, pea gravel	55	90
Coarse sand, gravel	90	112

Cleveland, Mississippi  
(mailing address)

WELL LOCATION:


sec. 26 T 23 N R 6 E

4 miles S.W. of Cleveland  
(distance) (direction) (nearest town)

WELL PURPOSE: irrigation  
(home, irrigation, municipal, industrial)

WELL COMPLETION DATA:

- (1) diameter (inches) 16"
- (2) total depth (feet) 112'
- (3) static water level (feet) 21' 2" <sup>static</sup> above top of ground.
- (4) casing steel 64' (material) (depth)  
16" (size) if telescope see back.
- (5) screen 48' 112' (length) (depth to top)  
16" Friedman (size) (material)
- (6) pump 39 1500 (HP) (yield gpm)  
electric (type power)
- (7) electric log no (yes or no)  
(organization running log)
- (8) how well bottom plugged plate

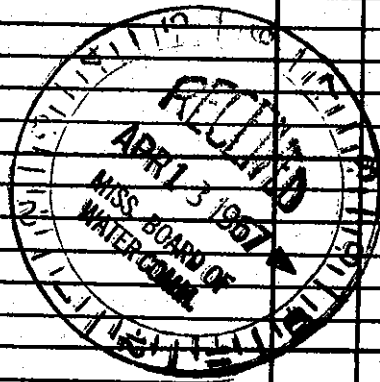

DRILLERS REMARKS: