

CODED

CODED

8/3/67  
JW  
2503

MISSISSIPPI  
BOARD OF WATER COMMISSIONERS  
416 North State Street  
Jackson, Mississippi 39201

WATER WELL DRILLERS LOG

BOLIVAR  
G 101  
7-67


July 26, 1967 Layne-Central Company Bolivar  
date well completed firm name county well located

LANDOWNER: D. B. Kitching  
Merigold, Mississippi  
(mailing address)  
WELL LOCATION:  
sec. 27 T. 23 N R. 6 xxx  
38E W  
5 miles west of Merigold  
(distance) (direction) (nearest town)  
WELL PURPOSE: irrigation  
(home, irrigation, municipal, industrial)

description of formations encountered	from	to
Clay	0	16
Coarse sand	16	50
Coarse sand, pea gravel	50	79
Coarse sand, pea gravel and gravel	79	120

WELL COMPLETION DATA:  
(1) diameter (inches) 12  
(2) total depth (feet) 120  
(3) static water level (feet) 25 ~~yards~~ above top of ground.  
(4) casing steel, 70' (material), (depth), 12" (size) if telescope see back.  
(5) screen 50' 120' (length), (depth to top), 12" Armco (size), (material)  
(6) pump 15 ~~1800~~ 1200 (HP), (yield gpm), electric (type power)  
(7) electric log no (yes or no), (organization running log)  
(8) how well bottom plugged plate

CODED

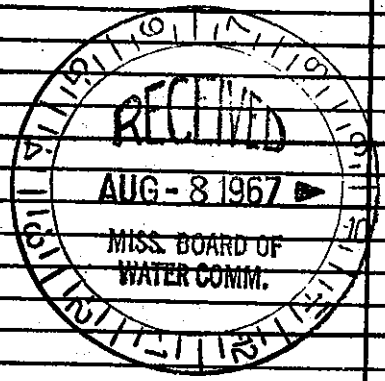

DRILLERS REMARKS: