

CODED

CODED

MISSISSIPPI
 BOARD OF WATER COMMISSIONERS
 416 North State Street
 Jackson, Mississippi 39201

WATER WELL DRILLERS LOG

Bolivar
G 105
2-67

8/30 1967 Delta Well Supply Co Bolivar
 date well completed firm name county well located

LANDOWNER:

Loddie Pruitt

description of formations encountered

from to

Merigold, Miss.
 (mailing address)

Top Clay 0 20
Fine Sand 20 35
Sand & gravel 35 101
Rock ?

WELL LOCATION:


sec. 1 T 23 N R 6 W
3 miles West Mount Boggs
 (distance) (direction) (nearest town)

WELL PURPOSE: Irrigation
 (home, irrigation, municipal, industrial)

WELL COMPLETION DATA:

- (1) diameter (inches) 12
- (2) total depth (feet) 101
- (3) static water level (feet) 21 below above top of ground.
- (4) casing steel 65
 (material) (depth)
12 If telescope see back.
 (size)
- (5) screen 36 65
 (length) (depth to top)
12 steel
 (size) (material)
- (6) pump 30 1650
 (HP) (yield gpm)
Tractor
 (type power)
- (7) electric log _____
 (yes or no)

CODED

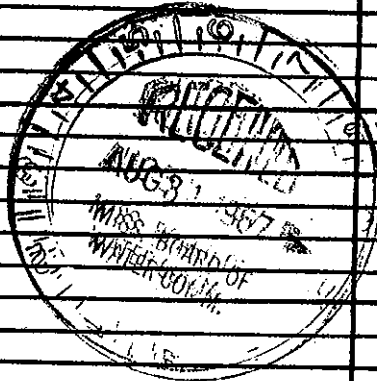

(organization running log)

(8) how well bottom plugged concrete

DRILLERS REMARKS: