

CODED

CODED

BOLIVER
G 109
3-68

MISSISSIPPI
 BOARD OF WATER COMMISSIONERS
 416 North State Street
 Jackson, Mississippi 39201

WATER WELL DRILLERS LOG

3/30 1968 date well completed
 1968 Delta Well & Supply Co Bolivar firm name
 Bolivar county well located

LANDOWNER:
 Halls Farms
 Cleveland, Miss.
 (mailing address)

description of formations encountered	from	to
Loam Clay	0	20
Loam Sand	20	55
Coarse Sand & Gravel	55	122

WELL LOCATION:
 sec. 1 T 23 N R 6 W
 2 1/2 miles West of Meridian
 (distance) (direction) (nearest town)

WELL PURPOSE: Irrigation
 (home, irrigation, municipal, industrial)

WELL COMPLETION DATA:

(1) diameter (inches) 16

(2) total depth (feet) 122

(3) static water level (feet) 20 below top of ground.

(4) casing steel (material) (depth) (size) If telescope see back.


(5) screen 40 (length) (depth to top) 16 steel (size) (material)

(6) pump 50 (HP) 2000 (yield gpm) Diesel (type power)

(7) electric log (yes or no) (organization running log)

(8) how well bottom plugged Cement.

CODED

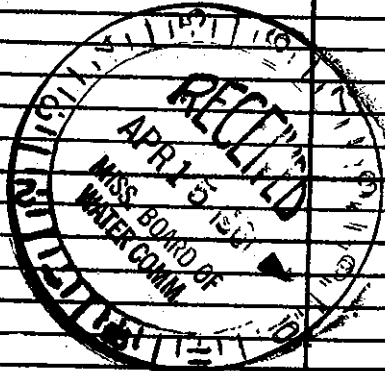

DRILLERS REMARKS: