

CODED

CODED

MISSISSIPPI
 BOARD OF WATER COMMISSIONERS
 416 North State Street
 Jackson, Mississippi 39201

WATER WELL DRILLERS LOG

Bolivar
G 111
10-4-68

1974
date well completed

188 Datta Well Supply Co.
firm name

Bolivar
county well located

LANDOWNER:
Wheeler Farm
Cleveland
 (mailing address)

WELL LOCATION:
 sec. 10 T. 23 N. R. 6 W.
5 miles west of Marygold
 (distance) (direction) (nearest town)

WELL PURPOSE: Irrigation
 (home, irrigation, municipal, industrial)

WELL COMPLETION DATA:

(1) diameter (inches) 16

(2) total depth (feet) 120

(3) static water level (feet) 22 below
 top of ground.

(4) casing steel
 (material) (depth)

_____ If telescope see back.
 (size)

(5) screen 40ft
 (length) (depth to top)

16 steel
 (size) (material)

(6) pump Diesel 3800
 (HP) (yield gpm)

4
 (type power)


(7) electric log _____
 (yes or no)

_____ (organization running log)

(8) how well bottom plugged Cement

description of formations encountered	from	to
<u>Top soil sandy</u>	<u>0</u>	<u>26</u>
<u>fine sand</u>	<u>26</u>	<u>70</u>
<u>good "</u>	<u>70</u>	<u>90</u>
<u>hard sand</u>	<u>90</u>	<u>110</u>
<u>" rock</u>	<u>110</u>	<u>111</u>
<u>good sand</u>	<u>111</u>	<u>120</u>

CODED

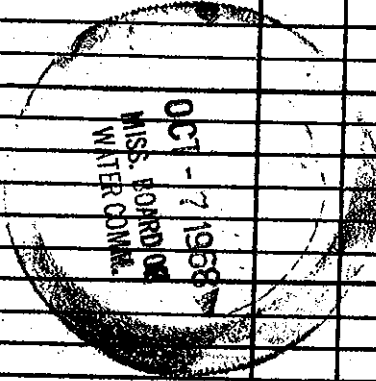

DRILLERS REMARKS: