


BOLIVAR
 CL-1520
G 145
10-15-80
 10/15 1980

MISSISSIPPI
 BOARD OF WATER COMMISSIONERS
 416 North State Street
 Jackson, Mississippi 39201

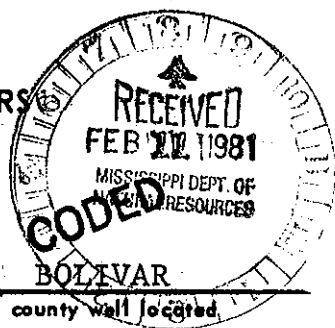

WATER WELL DRILLERS LOG

LAYNE-CENTRAL CO.

BOLIVAR
 county well located

date well completed

firm name

county well located

| LANDOWNER: | | description of formations encountered | from | to |
|---|--|---------------------------------------|------|-----|
| J.R. TAYLOR | | | | |
| PACE, MS | | clay | 14 | 22 |
| (mailing address) | | fine sand | 22 | 32 |
| #1 WELL LOCATION: | | " | 32 | 42 |
| sec. <u>31</u> T. <u>23</u> (N) R. <u>6</u> (E) | | " | 42 | 52 |
| S (W) | | coarse sand | 52 | 62 |
| <u>1</u> miles N of Pace | | " " | 62 | 72 |
| (distance) (direction) (nearest town) | | " & gravel | 72 | 82 |
| WELL PURPOSE: <u>irrigation</u> | | " " | 82 | 92 |
| (home, irrigation, municipal, industrial) | | " " | 92 | 102 |
| WELL COMPLETION DATA: | | " " | 102 | 115 |
| (1) diameter (inches) <u>28"</u> | | | | |
| (2) total depth (feet) <u>115'</u> | | | | |
| (3) static water level (feet) <u>26'</u> below top of ground. | | | | |
| (4) casing <u>steel</u> <u>75'</u> | | | | |
| (material) (depth) | | | | |
| <u>12"</u> if telescope see back. | | | | |
| (size) | | | | |
| (5) screen <u>40'</u> <u>75'</u> | | | | |
| (length) (depth to top) | | | | |
| <u>12"</u> st. steel | | | | |
| (size) (material) | | | | |
| (6) pump <u>30</u> <u>1800</u> | | | | |
| (HP) (yield gpm) | | | | |
| <u>electric</u> | | | | |
| (type power) | | | | |
| (7) electric log <u>no</u> | | | | |
| (yes or no) | | | | |
| (organization running log) | | | | |
| (8) how well bottom plugged <u>st. plate</u> | | | | |
| DRILLERS REMARKS: | | | | |