

MISSISSIPPI DEPARTMENT OF NATURAL RESOURCES

Bureau of Land and Water Resources

Southport Mall

P.O. Box 10631

Jackson, Mississippi 39201

WATER WELL DRILLERS LOG

BUTANE GAS CO. OF GREENWOOD

CODED

Bolivar


BOLIVAR
G-148
3/25/81
3-25-81 19

date well completed

firm name

county well located

LANDOWNER:	description of formations encountered	from	to
MARY COLEMAN			
MOUND BAYON (mailing address)	Clay	0	14
	SAND	14	48
	SAND + Red Gravel	48	70
	SAND + Gravel	70	106
WELL LOCATION:			
sec. <u>3</u> T. <u>23</u> N. R. <u>6</u> E. S. <u>W</u>			
<u>1/2</u> miles <u>SW</u> of <u>Mound Bayon</u> (distance) (direction) (nearest town)			
WELL PURPOSE: <u>IRR</u> (home, irrigation, municipal, industrial)			
WELL COMPLETION DATA:			
(1) diameter (inches) <u>16"</u>			
(2) total depth (feet) <u>106</u>			
(3) static water level (feet) <u>30</u> below top of ground.			
(4) casing <u>Steel</u> , <u>66</u> , (material) (depth) <u>16"</u> if telescope see back. (size)			
(5) screen <u>40</u> , <u>66</u> (length) (depth to top) <u>16"</u> , <u>Steel</u> (size) (material)			
(6) pump <u>60</u> <u>2500</u> (HP) (yield gpm) <u>Diesel</u> (type power)			
(7) electric log <u>NO</u> (yes or no) (organization running log)			
(8) how well bottom plugged <u>Steel Plate</u>			
DRILLERS REMARKS:			

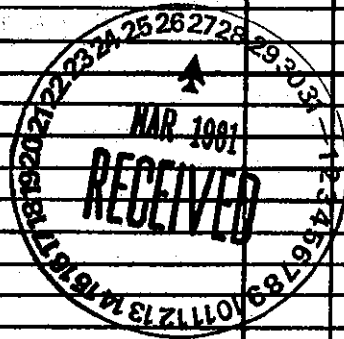

DEPT. OF NATURAL RESOURCES
 BUREAU OF LAND & WATER RESOURCES

MAR 27 1981

RECEIVED