

BOLIVAR
G 150
11-26-80

MISSISSIPPI DEPARTMENT OF NATURAL RESOURCES

Bureau of Land and Water Resources

Southport Mall

P.O. Box 10631

33571

Jackson, Mississippi 39209

WATER WELL DRILLERS LOG

CODED

11/26 1980
 date well completed

Bohler
 firm name

Bolivar
 county well located

LANDOWNER:
R. L. YEAGER
SKENE, MISS
 (mailing address)


description of formations encountered from to
 0'-33' clay - loam
 33'-60' sand
 60'-103' fine to heavy sand

WELL LOCATION:
 sec. 14 T. 23 N. R. 6 E
4 miles W of Merigold
 (distance) (direction) (nearest town)

WELL PURPOSE: Irrigation
 (home, irrigation, municipal, industrial)

WELL COMPLETION DATA:
 (1) diameter (inches) 12"
 (2) total depth (feet) 103'
 (3) static water level (feet) 22' below top of ground.
 (4) casing Steel 103'
 (material) (depth)
12" If telescope see back.
 (size)
 (5) screen 40" 63'
 (length) (depth to top)
12" Steel
 (size) (material)
 (6) pump 40 2000
 (HP) (yield gpm)
Quack
 (type power)
 (7) electric log (yes or no)
 (organization running log)
 (8) how well bottom plugged None

CODED

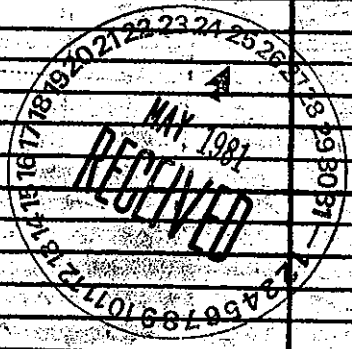

DRILLERS REMARKS: