

MISSISSIPPI DEPARTMENT OF NATURAL RESOURCES

Bureau of Land and Water Resources

Southport Mall

P.O. Box 10631

Jackson, Mississippi 39209

WATER WELL DRILLERS LOG

CODED

Bolivar
G 151
2-20-81
CL-1756

2-20 19 81 Lavne-Central Company Bolivar
 date well completed firm name county well located

LANDOWNER:	description of formations encountered	from	to	
Rayner Farms	Clay	0	14	
Merigold, MS (mailing address)	Fine sand	13	22	
	Fine sand	22	32	
WELL LOCATION: sec. 9 T. 23 S. R. 6 E 5 miles NW of Merigold (distance) (direction) (nearest town)	Med. Coarse sand	32	42	
	Coarse sand	42	52	
	Coarse sand	52	62	
	Coarse sand & Gravel	62	72	
	Coarse sand & Gravel	72	82	
	Coarse sand & Gravel	82	102	
	Coarse sand & Gravel	102	117	
	Clay	117	119	
	WELL PURPOSE: irrigation (home, irrigation, municipal, industrial)			

CODED

WELL COMPLETION DATA:

(1) diameter (inches) 32"

(2) total depth (feet) 120'

(3) static water level (feet) 19' ^{below} _{above} top of ground.


(4) casing Steel 80' (material) (depth)
 12" (size) if telescope see back.

(5) screen 40' 80' (length) (depth to top)
 12" Doerr (size) (material)

(6) pump 25 1500 (HP) (yield gpm)
 Electric (type power)

(7) electric log no (yes or no)
 none (organization running log)

(8) how well bottom plugged steel plate

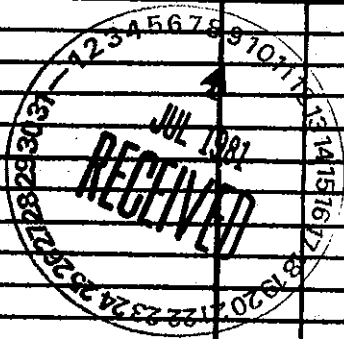

DRILLERS REMARKS