| | • | L |
|--|---|---|
| | | |
| | | |
| | | |

| | State Well Report | For Office |
|--|--|---|
| County: Polivary Permit #: 6W 39853 Driller: Clappen Smith Date drilling completed: 118/04 | Part 1 Mississippi Department of Environmental Quality Office of Land and Water Resources P.O. Box 10631 Jackson, MS 39289-0631 (601)961-5210 (601)354-6938 (fax) | For Office Aquifer: Well #: L. S. Elevation: B-log #: |
| | (***) | |

Use Only:

| State Law requires that this report be prepared by the 30 days of completion of drilling of the well. | driller in detail and filed with the Department within | |
|---|---|--|
| Well Owner Information | Well Location | |
| Owner Name Rayner Planting Co. | Latitude: 33° S1 , 50 " Longitude: 90 • 50 '09 " | |
| Mailing Address: | Method of Lat/Long (circle one): Conventional Survey, | |
| (4.0. Box 325 | USGS quad, Hand-held GPS, Survey-grade GPS | |
| Muigold MS 38759 City State Zip Code | NE 1/ NE 1/ Sec 8 Twn 23N Rng 6W | |
| Telephone No. (662) '748 - 2245 | Distance Direction Nearest Town 5 Miles SW of Mound Bayou | |
| Well | Data | |
| Purpose of Well (circle one) Home Industrial Public Supply | Irrigation Fish Culture Other: | |
| Date well drilling started: 11804 Date v | well drilling completed: 118/04 | |
| If flowing, method of flow regulation: Valve NA Other (d | describe) | |
| Static Water Level:feet above or below (circle one) | land surface Date measured: 11804 | |
| Method of Measurement (circle one) steel tape electric tape air line other: | | |
| Hole depth: 124 Well depth: 124 Well grouted to a depth of 10 feet | | |
| Type of grout (circle one): Cement Bentonite Mix | | |
| Casing length: 84 feet Casing diameter: 16 | inches Type of casing: PVC | |
| Screen length: 40 feet Screen diameter: 10 | inches Type of screen: PVC | |
| Screen slot size: 0.050 inches Setting depth: From | 84 feet to 124 feet | |
| Type of completion (circle all applicable): Gravel packed Under | rreamed Telescoped Open hole Natural Development | |
| Other (describe): | | |
| Top of lap pipe or reduction in casing: NA feet. If to | elescoped or more than one screen, describe on back of page | |
| Logs run (circle all applicable): No log run Electric Gamma Ray | | |
| Name of organization running log(s): | | |
| I certify that the well was drilled, constructed, and completed in | / | |
| Department of Environmental Quality and/or the Mississippi De | epartment of Health regulations and state laws. | |
| Tommy G. Chrestman 0-703 | 3 / Mm/ Morton | |
| Print Name of Water Well Contractor and License No. | Signature of Water Well Contractor | |
| | HEUEIVED | |

NOV 1 6 2004

BY: OLWR


| If well telescopes please sketch | below | and she | ow depths. |
|----------------------------------|-------|---------|------------|
| | , | _ | • |

Mid-South Water

| Ground Level | NA | 6-200 |) |
|--------------|-----|-------|---|
| | | | |
| | | | |
| |] ' | | |

| Description of Formations Encountered | From | To |
|---|--------------|--|
| HARD CLAY | 0 | 24 |
| FINE SAN'D | 24 | 60 |
| COARSE SAND GRAVEL | 60 | 72 |
| COARSE SAND, GRAVEL FINE SAND COARSE SAND, GRAVEL | 72 | 82 |
| COARSE SAND GRAVEL | 182 | 124 |
| CLAY ' | 124 | 124 |
| | | ╁ |
| | | |
| | | \vdash |
| | | 1 -1 |
| | | + |
| | | |
| | | |
| | | 1 1 |
| | | \vdash |
| | 7 | |
| | | \vdash |
| | | |
| | | |
If more than one screen, show location of each on sketch

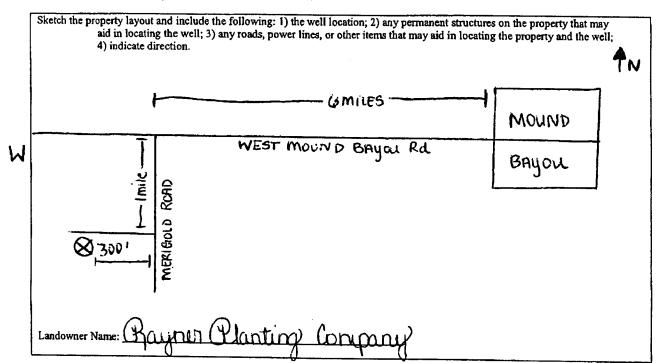

* NOTE: New Well is 10'5 of old Well (Permit # GW5292)

Old well was abandoned.

RECEIVED

NOV 1 6 2004

BY: OLWR

Jan 13 05 09:08a

Permit #:

County: Bolivar

Mid-South Water

(662)843-1717

p.2

STATE WELL REPORT

Part 2

Pump Installer's Completion Report
Mississippi Department of Environmental Quality
Office of Land and Water Resources
P.O. Box 10631 Jackson, MS 39289-0631 (601)961-5210

| For Office Use Only: |
|----------------------|
| Aquifer: |
| Well #: 6-205 |
| Elevation: |

| Date completed: 1110107 | (601)354 | -6938 (fax) | Elevation: |
|--|----------------------------|---|------------------------------------|
| This report should be prepared by th installation of pump. | e pump installer in detail | and filed with the Departmen | t within 30 days of the |
| Well Owner Information | | Well Location | |
| Owner Name: Rouner Planting Co. | | Latitude: | Longitude: |
| Mailing Address: | | Method of Lat/Long (circle one): Conventional Survey, | |
| P.D. Box 325 | | USGS quad, Hand-held GPS, Survey-grade GPS | |
| Merigold MS 38759 City State Zip Code | | | |
| Chy 5 date | | Distance Direction | Nearest Town |
| Telephone No. (662) 748-2245 | | | Mound Bayou |
| Pump Type Circle one | | | wer Type ircle one |
| Air Lift Jet | Submersible | Diesel Engine Gasolin | ne Engine Natural Gas |
| Bucket Piston | Turbine | Electric Motor Hand | Tractor PTO |
| Centrifugal Rotary | Flowing Well | Windmill Other | (specify): |
| Other (specify): | | Horse Power Rating of Motor | :_40 |
| Date Pump Installed: 181304 | | Setting Depth: 70 | feet |
| Rated Pump Capacity: 1500 | _Gallons Per Minute | Number of Stages: | <u> </u> |
| | | | |
| Pump Test Data | | | easuring Water Level lircle one |
| Date Well Tested: ND+ TPSTE | | Air Line Electric Mer | asuring Line (Steel Tape) |
| Static Water Level (A): 42'6" Feet Below Land Surface | | Other (specify): | |
| Pumping Water Level (B): <u>W//A</u> Feet Below Land Surface | | Company), | |
| Drawdown [(B) - (A)]: N/A Feet Below Land Surface | | ļ , | hut in head: <u>N/A</u> feet |
| Test Pumping Rate: N/A Gallons Per Minute | | Well yielded N/A | GPM with a drawdown of |
| Duration of Pump Test (minimum 4 hours) |): <u>////</u> hours | feet after_ | hours of pumping |

| I HEREBY CERTIFY that the above statements are true to the b | pest of my knowledge. |
|--|-----------------------------|
| Tommy G. Chrestman D-703 | Jonny Morney |
| Print Name of Pump Installer and License No. (if applicable) | Signature of Pump Installer |