	State Well Report	7 07 7 01			
County: Bolivar	Part 1	For Office Use Only:			
Mississip	oi Department of Environmental Quality	Aquifer:			
Permit #: <u>GW40696</u> Irrigation Equipment	ice of Land and Water Resources P.O. Box 10631	Well #: 6 - (1/1)			
Driller:	Jackson, MS 39289-0631	L. S. Elevation:			
Driller:	(601)961-5210				
	(601)354-6938 (fax)	E-log #:			
State Law requires that this report be prepared by the driller in detail and filed with the Department within					
30 days of completion of drilling of the wel Well Owner Information	W	ell Location			
Owner Name LWD Enterprises	Latitude: 33, 52 , 5	3N Longitude: 90. 48.37W			
Mailing Address: Box 189	Method of Lat/Long (circle	1 27 1			
		ld GPS, Survey-grade GPS			
Ohalla va 2022	SW NE 1/2 Sec_ 3	$\frac{\checkmark}{\text{Twn}} \frac{23\text{N}}{\text{Rng}} \frac{6\text{W}}{\text{M}}$			
Shelby, MS 3877 City State Zi	p Code Distance Direction	Nearest Town			
	<u>5</u> Miles West	of Mound Bayou			
Telephone No. ()_	_				
	Well Data				
Purpose of Well (circle one) Home Industrial Po	ablic Supply Irrigation Fish Culture	Other:			
Date well drilling started: 11-22-	Date well drilling started: 11-22-05 Date well drilling completed: 11-22-05				
If flowing, method of flow regulation: Valve	Other (describe)				
Static Water Level: 49 feet above or below	(circle one) land surface Date measured	: 11-23-05			
Method of Measurement (circle one) steel tape	electric tape air line other:				
Hole depth: 125 Well depth:	Well grouted to a depth of	1 <u>0</u> fcet			
Type of grout (circle one): Cement Bentoni	e Mix				
Casing length: 85 feet Casing diameter.	16 inches Type of casing:	PVC Sch.40			
Screen length: 40 feet Screen diameter	16 inches Type of screen:	PVC Sch.40			
Screen slot size:	depth: From 86 feet to 12	25 feet			
Type of completion (circle all applicable): Gravel packed Underreamed Telescoped Open hole Natural Development					
Other (describe):					
Top of lap pipe or reduction in casing:feet. If telescoped or more than one screen, describe on back of page					
Logs run (circle all applicable): No log run Electric Gamma Ray Density Sonic Neutron Other:					
Name of organization running log(s): I certify that the well was drilled, constructed, and completed in accordance with all applicable requirements of the Mississippi					
Department of Environmental Quality and/or the N	•	i			

Irrigation Equipment Inc. Patrick M. Chism 0695


Print Name of Water Well Contractor and License No.

Signature of Water Well Contractor

Ground Level

Description of Formations Encountered	From	То
Clav	0	21
Fine Sand Fine Sand/gravel Med. Sand/gravel	22	35
Fine Sand/gravel	36	58
Med. Sand/gravel	59	125
		\vdash
		-
		-
		\vdash
		├ ──
		—-
		$ldsymbol{\sqcup}$
		$\sqcap \sqcap$
		1

If more than one screen, show location of each on sketch

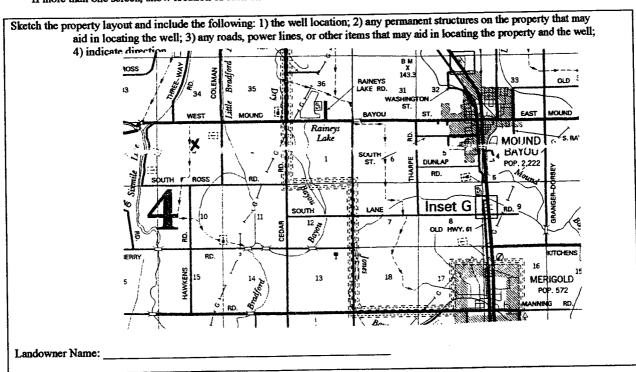

Signature of Water Well Contractor

STATE WELL REPORT

Part 2

Bolivar Pump Installer's Completion Report
Mississippi Department of Environmental Quality
Office of Land and Water Resources County: _ Permit#: <u>GW40696</u> Irrigation Equipment Driller: _____ P.O. Box 10631 Jackson, MS 39289-0631 11-23-05 (601)961-5210

For Office Use Only:		
Aquifer:		
Well #: _	6-217	
Elevation	:	

	(601)3	54-6938 (fax)	Elevation:	
This report should be prepared by the installation of pump.	e pump installer in de	tail and filed with the Dep	artment within 30 d	ays of the
Well Owner Information	ion		Well Location	<u> </u>
Owner Name: LWD Enterpri	ses	Latitude:	Longitude:	
Mailing Address: Box 189		Method of Lat/Long (circle one): Conventional Survey,		
		USGS quad,	Hand-held GPS, Su	rvey-grade GPS
Shelby, MS		SW4 NE 4 Se	c 3 Twn 2	3N _{kng} 6W
City State	Zip Code	Distance Direct	tion Nearest T	own
Telephone No. ()		5 Miles Wes	t of Mound	Bayou
Pum p Type Circle one			Power Type Circle one	***************************************
Air Lift Jet (Submersible	Diesel Engine	Sasoline Engine	Natural Gas
Bucket Piston	Turbine	Electric Motor	Hand	Tractor PTO
Centrifugal Rotary	Flowing Well	Windmill	Other (specify):	
Other (specify):		Horse Power Rating of	Motor: 25	
Date Pump Installed: 11-23	3-05	Setting Depth:	70	feet
Rated Pump Capacity: 1100	Gallons Per Minute	Number of Stages:		
Pump Test Data		Method	of Measuring Water Circle one	r Level
Date Well Tested:		Air Line Electri	c Measuring Line	Steel Tape
Static Water Level (A):Feet	Below Land Surface	Other (specify):	-	•
Pumping Water Level (B):Feet	Below Land Surface	Carrotte (Change)		, , ,
Drawdown [(B) - (A)]:Feet	Below Land Surface	For flowing well, measu	ured shut in head:	feet
Test Pumping Rate:	Gallons Per Minute	Well yielded	GPM with a	drawdown of

I HEREBY CERTIFY that the above statements are true to the best	of my knowledge.	
Patrick M. Chism 0695	Pahel M Chy	•
Print Name of Pump Installer and License No. (if applicable)	Signature of Pump Installer	

RECEIVED

DEC 0 5 2005

BY: OLWR