State W	'ell Report			
	For Office Use Univ:			
	art 1 t of Environmental Quality			
Irrigation Equipment POF	and Water Resources Sex 10631 Well #: 6-23			
	IS 39289-0631 L. S. Elevation:			
1 3-5-11/ 1	961-5210			
(601)35	4-6938 (fax) E-log #:			
State Law requires that this report be prepared by the	driller in detail and filed with the Department within			
30 days of completion of drilling of the well.				
Well Owner Information	Well Location			
Owner Name Pemble Farms	Latitude: 33 ° 49 '15 " Longitude: 90 ° 46' 16 "			
Mailing Address: Box 428	Method of Lat/Long (circle one): Conventional Survey,			
	USGS quad, Hand-held GPS, Survey-grade GPS			
Merigold MS 38759	NE 1/4 NW Sec 25 Twn 23N Rng 6W			
City State Zip Code	Distance Direction Nearest Town			
662_748_2330	3 Miles SW of Merigold			
Telephone No. ()	-			
Well I	Deta :			
wen i	O ata			
Purpose of Well (circle one) Home Industrial Public Supply	Arrigation Fish Culture Other.			
Date well drilling started: 3-5-07 Date w	well drilling completed: 3-5-07			
If flowing, method of flow regulation: Valve Other (d	escribe)			
Static Water Level: 47 feet above or clow (2 ircle one) l	and surface Date measured: $3-6-0.7$			
Method of Measurement (circle one) seel tape electric tape air line other:				
Hole depth: 127 Well depth: 127	Well grouted to a depth of10feet			
Type of grout (circle one): Cement Bentonite) Mix				
Casing length: 87 feet Casing diameter: 16	_inches Type of casing:PVC Sch. 40			
Screen length: 40 feet Screen diameter: 16	inches Type of screen: PVC Sch. 40			
Screen slot size: o 50 inches Setting depth: From	88 feet to 127 feet			
Type of completion (circle all applicable): Gavel packet Underreamed Telescoped Open hole Natural Development				
Other (describe):				
Top of lap pipe or reduction in casing: feet. If telescoped or more than one screen, describe on back of page				
Logs run (circle all applicable): No log run Electric Gamma Ray Density Sonic Neutron Other:				
Name of organization running log(s): I certify that the well was drilled, constructed, and completed in accordance with all applicable requirements of the Mississippi				

Department of Environmental Quality and/or the Mississippi Department of Health regulations and state

Irrigation Equipment Inc. Patrick M. Chism 0695

Print Name of Water Well Contractor and License No.

RECEIVED

Signature of Water Well Contractor

MAR 26 2007


BY: OLWR

Ground Level

Descri	ption of Formations Encountered	From	To_
Clay		0	19
Fine .	Sand	20	35
Fine :	Sand/gravel Sand/gravel	36	50
Med.	Sand/gravel	51	127
			L
		ļ <u> </u>	
		ļ	-
			
		ļ	-
		 	
		 	 —
		├	
		 	├ ──
		1	<u> </u>

If more than one screen, show location of each on sketch

Sketch the property layout and include the following: 1) the well location; 2) any permanent structures on the property that may aid in locating the well; 3) any roads, power lines, or other items that may aid in locating the property and the well; 4) indicate direction.

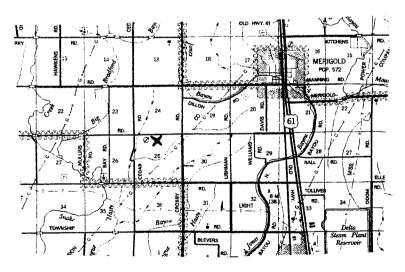

Landowner Name:

Signature of Water Well Contractor

STATE WELL REPORT

Bolivar Permit#: 6W 41585 Irrigation Equipment 3-5-07 Date completed:

Part 2 Pump Installer's Completion Report Mississippi Department of Environmental Quality Office of Land and Water Resources P.O. Box 10631 Jackson, MS 39289-0631

(601)961-5210 (601)354-6938 (fax)

For Office Use Only:	
Aquifer:	
Well#: 6-223	
Elevation:	-

	Well Owner Infor	mation		Well Location	
Owner Name: P	emble Far	ns	Latitude:	Longitude:	
Mailing Address:	Box 428		Method of Lat/Long (circle one): Conventional Survey,		
_	Merigold	MS 38759	1	i, Hand-held GPS, S	• •
C		te Zip Code	NE % NW %	Sec 25 Twn 2	BN Rng 6W
Celephone No. ()			ction Nearest 7	
Pump Type Circle one			Power Type Circle one		
Air Lift	Jet	Submersible	Diesel Engine	Gasoline Engine	Natural Gas
Bucket	Piston	Turbine	Electric Motor	Hand	Tractor PTO
Centrifugal	Rotary	Flowing Well	Windmill	Other (specify):	
ther (specify):			Horse Power Rating of	Motor: 60	
ate Pump Installed:		-6-07	Setting Depth:	70	feet
ated Pump Capacity	2800±	Gallons Per Minute	Number of Stages:	1	
Punap Test Data		Method of Measuring Water Level Circle one			
Pate Well Tested:			Air Line Electr	ic Measuring Line	Steel Tape
		eet Below Land Surface	Other (specify):	_	-
umping Water Level	I (B):Fe	et Below Land Surface	Carri (apoons).		
rawdown [(B) – (A)]:Fo	et Below Land Surface	For flowing well, meas	ured shut in head:	feet
		Gallons Per Minute	Well yielded	GPM with a	drawdown of
est rumping Kate: _					

I HEREBY CERTIFY that the above statements are true to the be	st of my knowledge.	·
Patrick M. Chism 0695	Tal IVI a	
Print Name of Pump Installer and License No. (if applicable)	Signature of Pump Installer	
		RECEIVED

MAR 26 2007