

State Well Report

Part 1 - Driller's Log

Mississippi Department of Environmental Quality
 Office of Land and Water Resources
 P.O. Box 2307
 Jackson, MS 39225
 (601)961- 5210
 (601)961- 5228 (fax)

County: Bolivar
 Permit #: GW-44090
 Driller: Clarence M. Murry
 Date drilling completed: 4-14-10

For Office Use Only:
 Aquifer: G 242
 Well #: _____
 L. S. Elevation: _____
 F-log #: _____

State Law requires that this report be prepared by the license holder responsible for the work and filed with the Department at the above address within 30 days of completion of drilling of the well or borehole.

Information on Well Owner (Landowner if borehole is not for a water well)	Well or Borehole Location
Owner Name: <u>Wheeler Farms</u>	Latitude: <u>N 33° 48' 22.6"</u> Longitude: <u>W 90° 48' 54.5"</u>
Mailing Address: <u>632 Oswalt Rd.</u>	Method of Lat/Long (circle one): Conventional Survey
<u>Merigold MS 38759</u>	USGS quad, <u>Hand-held GPS</u> , Survey-grade GPS
City State Zip Code	<u>NE 1/4 Sec 33 Twn 23N Rng 6W</u>
Telephone No. <u>(662) 721-0412</u>	Distance Direction Nearest Town <u>2 Miles NE of FACE</u>

Well / Borehole Data

Date drilling started: 4-14-10 Date drilling completed: 4-14-10 Hole depth: 121' Hole diameter: 26"

Location of the source of any surface water used for drilling: near by well

Method of dosing and volume of Chlorine used in drilling and development: _____

Logs run (circle all applicable): No log run Electric Gamma Ray Density Sonic Neutron Other: _____

Name of organization running log(s): _____

Purpose of borehole (check one): Water Well Geotechnical/Geological Investigation _____ Ground Source Heat Pump _____

Seismic Survey _____ Other (describe) _____

If drilling is not related to water well construction, skip the remainder of this block

Purpose of Well (check one): Home _____ Industrial _____ Public Supply _____ Irrigation _____ Fish Culture _____ Other: _____

If a flowing well, method of flow regulation: Valve _____ Other (describe) _____

Static Water Level: 40 feet above or below (circle one) land surface Date measured: 4-14-10

Method of Measurement (circle one) steel tape electric tape air line other: _____

Well depth: 120' Well grouted to a depth of 10 feet Type of grout (circle one): Best Cement Bentonite Mix

Casing length: 80 feet Casing diameter: 16 inches Type of casing: PVC

Screen length: 40 feet Screen diameter: 16 inches Type of screen: PVC

Screen slot size: .050 inches Setting depth: From 80 feet to 120 feet

Type of completion (circle all applicable): Gravel packed Underreamed Telescoped Open hole Natural Development

Other (describe): _____


Top of lap pipe or reduction in casing: N/A feet. *If telescoped or more than one screen, describe on next page*

6242

The sketch below only required for water wells

Description of formations encountered must be provided for all wells and borholes, unless specifically exempted by regulations


If well telescopes, show depths on sketch

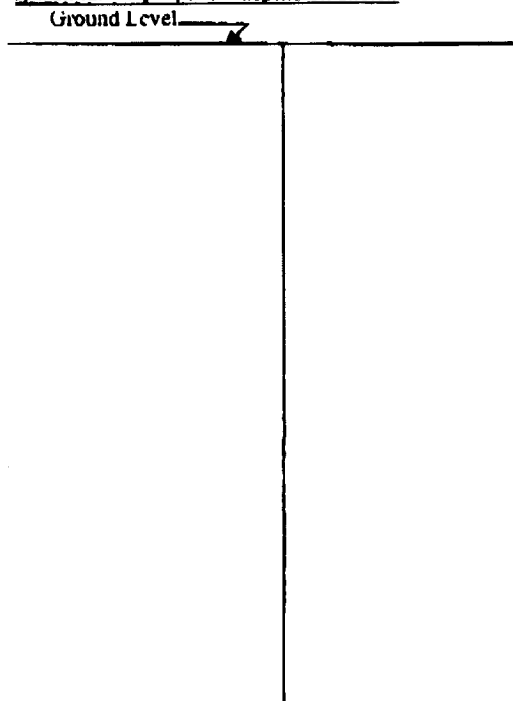

Description of Formations Encountered	From (depth)	To (depth)
CLAY	Ground Level	16
Clay & Fine Sand	16	27
Medium Sand	27	50
Medium Coarse Sand & pea gravel	50	66
Coarse Sand & gravel	66	121

If more than one screen, show location of each on sketch

Sketch the property layout and include the following: 1) the well location; 2) any permanent structures on the property that may aid in locating the well; 3) any roads, power lines, or other items that may aid in locating the property and the well; 4) a north arrow.

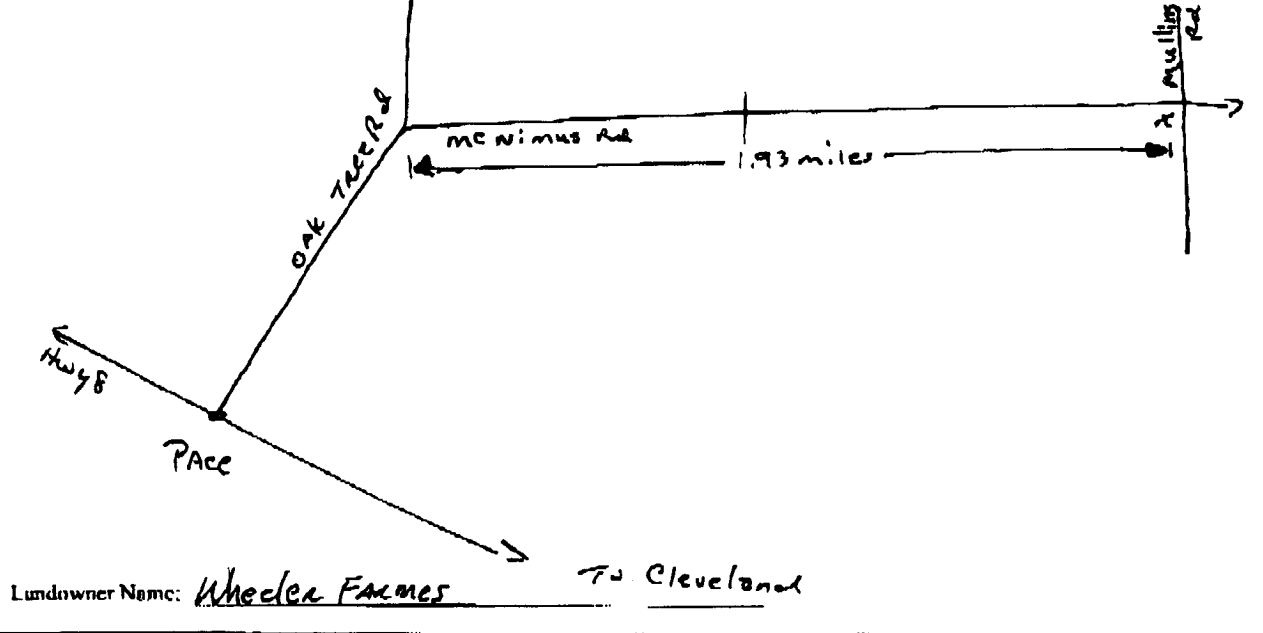

Form: OLWR-SWR-1A (04/08)

I certify that the well/borehole was drilled, constructed, and completed in accordance with all applicable requirements of the Mississippi Department of Environmental Quality and the Mississippi Department of Health regulations, if applicable, and state laws.

Clayton Miller 0-703 4-18-10 Clayton Miller
 Print Name of Responsible Licensee and License No. Date Signature of Licensee

STATE WELL REPORT

Part 2

Pump Installer's Completion Report
 Mississippi Department of Environmental Quality
 Office of Land and Water Resources
 P.O. Box 2309
 Jackson, MS 39225
 (601)961-5210
 (601)961-5228 (fax)

County: Bolivar
 Permit #: GW-44090
 Driller: John Morgan
 Date completed: 4-14-10
 Copy information from block on Part 1

For Office Use Only:
 Aquifer: 6242
 Well #: _____
 Elevation: _____

This part of the report must be completed by a licensed water well contractor or a licensed pump installer. A copy of Part 1 of the report must be attached and both parts filed with the Department at the above address within 30 days of well completion.

Well Owner Information	Well Location
Owner Name: <u>Wheeler Farms</u>	Latitude: <u>N33° 48' 22.6"</u> Longitude: <u>W90° 48' 54.35"</u>
Mailing Address: <u>632 Oswalt Rd</u>	Method of Lat/Long (check one): Conventional Survey _____
<u>Merigold</u> MS <u>38759</u>	USGS quad _____, Hand-held GPS <input checked="" type="checkbox"/> , Survey-grade GPS _____
City State Zip Code	1/4 _____ 1/4 Sec: <u>33</u> T <u>23N</u> R <u>6W</u>
Telephone No. <u>(662) 721-0412</u>	Distance Direction Nearest Town
	<u>2</u> Miles <u>NE</u> of <u>PACE</u>

Pump Type Circle one	Power Type Circle one
Air Lift Jet <u>Submersible</u>	Diesel Engine Gasoline Engine Natural Gas
Bucket Piston Turbine	<u>Electric Motor</u> Hand Tractor PTO
Centrifugal Rotary Flowing Well	Windmill Other (specify): _____
Other (specify): _____	Horse Power Rating of Motor: <u>40</u>
Date Pump Installed: <u>4-14-10</u>	Setting Depth: <u>80</u> feet
Rated Pump Capacity: <u>1700</u> Gallons Per Minute	Number of Stages: <u>1</u>

Pump Test Data	Method of Measuring Water Level Circle one
Date Well Tested: <u>NOT TESTED</u>	Air Line <u>Electric Measuring Line</u> Steel Tape
Static Water Level (A): <u>40</u> Feet Below Land Surface	Other (specify): _____
Pumping Water Level (B): <u>N/A</u> Feet Below Land Surface	For flowing well, measured shut in head: <u>N/A</u> feet
Drawdown [(B) - (A)]: <u>N/A</u> Feet Below Land Surface	Well yielded _____ GPM with a drawdown of _____ feet after _____ hours of pumping
Test Pumping Rate: <u>N/A</u> Gallons Per Minute	
Duration of Pump Test (minimum 4 hours): <u>N/A</u> hours	

I HEREBY CERTIFY that the above statements are true to the best of my knowledge.

Clayton Miller 0-703
 Print Name of Pump Installer and License No. (if applicable) Signature of Pump Installer