

### State Well Report Part 1 - Driller's Log

Mississippi Department of Environmental Quality  
Office of Land and Water Resources  
P.O. Box 2309  
Jackson, MS 39225  
(601)961-5210  
(601)961-5228 (fax)

County: Bolivar  
 Permit #: GW-46498 ✓  
 Driller: Deecee Murray  
 Date drilling completed: 1-23-13

For Office Use Only:  
 Aquifer: \_\_\_\_\_  
 Well #: G274  
 L. S. Elevation \_\_\_\_\_  
 E-log #: \_\_\_\_\_

**State Law requires that this report be prepared by the license holder responsible for the work and filed with the Department at the above address within 30 days of completion of drilling of the well or borehole.**


<p><b>Information on Well Owner</b> (Landowner if borehole is not for a water well)</p> <p>Owner Name: <u>Fioravelli Bros. JV.</u>        Mailing Address: <u>P.O. Box 1596</u>  <u>Cleveland MS 38732</u>        City State Zip Code        Telephone No. <u>(662) 515-8340</u></p>	<p><b>Well or Borehole Location</b></p> <p>Latitude: <u>33° 48' 04.17"</u> Longitude: <u>90° 47' 26.91"</u>  <small>0A 27</small>        Method of Lat/Long (circle one): Conventional Survey,        USGS quad. Hand-held GPS, Survey-grade GPS  <u>SE 1/4 NW 1/4 Sec 35- Twn 23N Rng 06W</u>        Distance Direction Nearest Town        _____ Miles _____ of _____  <u>#1207 well #3</u></p>
<p><b>Well / Borehole Data</b></p> <p>Date drilling started: <u>1-23-13</u> Date drilling completed: <u>1-23-13</u> Hole depth: <u>125'</u> Hole diameter: <u>26"</u></p> <p>Location of the source of any surface water used for drilling: <u>near by ditch</u>        Method of dosing and volume of Chlorine used in drilling and development: _____</p> <p>Logs run (circle all applicable): <u>None run</u> Electric Gamma Ray Density Sonic Neutron Other: _____        Name of organization running log(s): _____</p> <p>Purpose of borehole (check one): Water Well <input checked="" type="checkbox"/> Geotechnical/Geological Investigation _____ Ground Source Heat Pump _____        Seismic Survey _____ Other (describe) _____  <u>If drilling is not related to water well construction, skip the remainder of this block</u></p> <p>Purpose of Well (check one): Home _____ Industrial _____ Public Supply _____ Irrigation _____ Fish Culture _____ Other: _____</p> <p>If a flowing well, method of flow regulation. Valve _____ Other (describe) _____</p> <p>Static Water Level: _____ feet above or <u>below</u> (circle one) land surface Date measured: _____</p> <p>Method of Measurement (circle one) steel tape <u>electric tape</u> air line other: _____</p> <p>Well depth: <u>125'</u> Well grouted to a depth of <u>10</u> feet Type of grout (circle one): <u>Neat Cement</u> Bentonite Mix</p> <p>Casing length: <u>75</u> feet Casing diameter: <u>16</u> inches Type of casing: <u>PVC</u></p> <p>Screen length: <u>50</u> feet Screen diameter: <u>16</u> inches Type of screen: <u>PVC</u></p> <p>Screen slot size: <u>.050</u> inches Setting depth: From <u>75</u> feet to <u>125</u> feet</p> <p>Type of completion (circle all applicable): <u>Gravel packed</u> Underreamed Telescoped Open hole Natural Development        Other (describe): _____</p> <p>Top of lap pipe or reduction in casing: <u>n/a</u> feet <u>If telescoped or more than one screen, describe on next page</u></p>	

G274

The sketch below only required for water wells

If well telescopes, show depths on sketch

Ground Level →

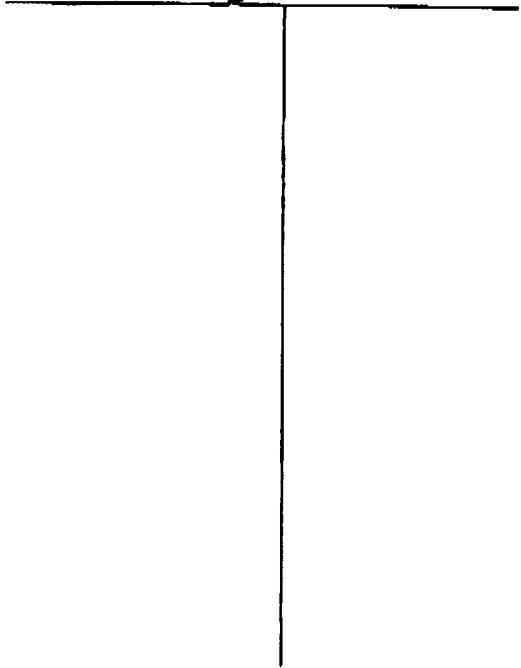


Description of formations encountered must be provided for all wells and boreholes, unless specifically exempted by regulations

Description of Formations Encountered	From (depth)	To (depth)
Clay	Ground Level	17
Fine Sand and Clay	17	23
Medium Sand	23	30
Medium Sand, Shell, Clay and Wood	30	
Fine Sand	39	48
Medium Sand	48	53
Medium/Coarse Sand and pea gravel	53	
Medium Sand		80
Medium/Coarse Sand and pea gravel	80	92
Coarse Sand and gravel	92	97
Medium Sand	97	119
Medium Coarse Sand? gravel	119	121
	121	125

If more than one screen, show location of each on sketch

Sketch the property layout and include the following: 1) the well location; 2) any permanent structures on the property that may aid in locating the well; 3) any roads, power lines, or other items that may aid in locating the property and the well; 4) a north arrow.

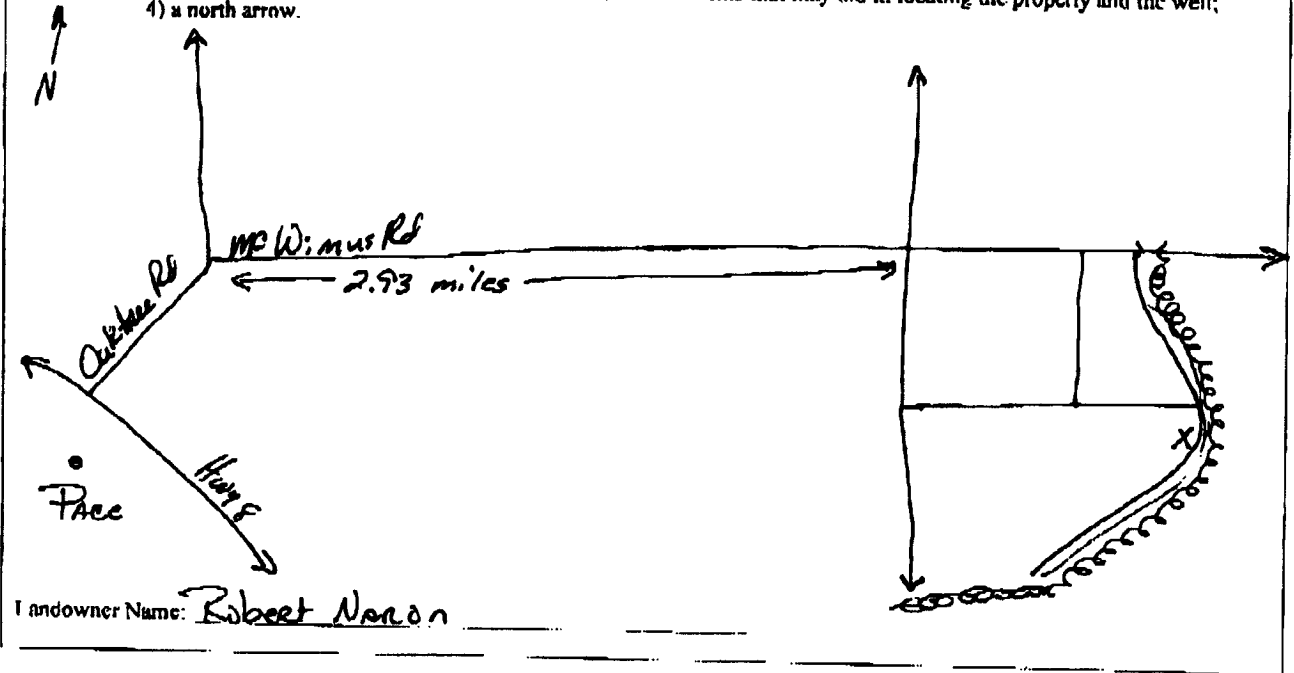

Form: OLWR-SWR-1A (04/08)

I certify that the well/borehole was drilled, constructed, and completed in accordance with all applicable requirements of the Mississippi Department of Environmental Quality and the Mississippi Department of Health regulations, if applicable, and state laws.

Clayton Miller 0-703 3-7-13  
Print Name of Responsible Licensee and License No. Date

Clayton Miller  
Signature of Licensee

# STATE WELL REPORT

## Part 2

**Pump Installer's Completion Report**  
 Mississippi Department of Environmental Quality  
 Office of Land and Water Resources  
 P.O. Box 2309  
 Jackson, MS 39225  
 (601)961-5210  
 (601)961-5228 (fax)

County: Bolivar  
 Permit #: GW-46498  
 Driller: John Rybolt IV  
 Date completed: 3-5-13  
*Copy information from block on Part 1*

**For Office Use Only:**  
 Aquifer: \_\_\_\_\_  
 Well #: G274  
 Elevation: \_\_\_\_\_

*This part of the report must be completed by a licensed water well contractor or a licensed pump installer. A copy of Part 1 of the report must be attached and both parts filed with the Department at the above address within 30 days of well completion.*

Well Owner Information	Well Location
Owner Name: <u>Fidrawell, Biles, JV.</u>	Latitude: <u>33° 48' 04.7"</u> Longitude: <u>90° 47' 26.91"</u>
Mailing Address: <u>P. O. Box 1596</u>	Method of Lat/Long (check one): Conventional Survey _____ USGS quad _____ Hand-held GPS <u>r</u> Survey-grade GPS _____
<u>Cleveland</u> <u>MS</u> <u>38732</u> City State Zip Code	<u>SE</u> $\frac{1}{4}$ <u>NW</u> $\frac{1}{4}$ Sec <u>35</u> T <u>23N</u> R <u>06W</u>
Telephone No. <u>(662) 515-9340</u>	Distance _____ Miles _____ Direction _____ of _____ Nearest Town _____

Pump Type	Power Type
Air Lift <input type="radio"/> Jet <input type="radio"/> Submersible <input type="radio"/>	Diesel Engine <input type="radio"/> Gasoline Engine <input type="radio"/> Natural Gas <input type="radio"/>
Bucket <input type="radio"/> Piston <input type="radio"/> <u>Turbine</u> <input type="radio"/>	Electric Motor <input type="radio"/> Hand <input type="radio"/> Tractor PTO <input type="radio"/>
Centrifugal <input type="radio"/> Rotary <input type="radio"/> Flowing Well <input type="radio"/>	Windmill <input type="radio"/> Other (specify): <u>Gear Drive</u>
Other (specify): _____	Horse Power Rating of Motor: <u>40</u>
Date Pump Installed: <u>3-5-13</u>	Setting Depth: <u>70</u> feet
Rated Pump Capacity: _____ Gallons Per Minute	Number of Stages: <u>2</u>

Pump Test Data	Method of Measuring Water Level
Date Well Tested: <u>027 785760</u>	Air Line <input type="radio"/> <u>Electric Measuring Line</u> <input checked="" type="radio"/> Steel Tape <input type="radio"/>
Static Water Level (A): <u>44</u> Feet Below Land Surface	Other (specify): _____
Pumping Water Level (B): <u>N/A</u> Feet Below Land Surface	For flowing well, measured shut in head: <u>N/A</u> feet
Drawdown [(B) - (A)]: <u>N/A</u> Feet Below Land Surface	Well yielded _____ GPM with a drawdown of _____ feet after _____ hours of pumping
Test Pumping Rate: <u>N/A</u> Gallons Per Minute	
Duration of Pump Test (minimum 4 hours): <u>N/A</u> hours	

This is for (circle one): New Well Replacement of Existing Pump Repair of Existing Pump

I HEREBY CERTIFY that the above statements are true to the best of my knowledge.

Clayton Miller 0-703 Clayton Miller  
 Print Name of Pump Installer and License No. (if applicable) Signature of Pump Installer