

STATE WELL REPORT

140

County: Bolivar
 Permit #: 289
 Driller: Gallen Williams
 Date drilling completed: Sept 1

**Part 1
 Driller's Log**
 Mississippi Department of Environmental Quality
 Office of Land and Water Resources
 P.O. Box 2309
 Jackson, MS 39225-2309
 (601)961-5555
 (601)961-5228 (fax)

For Office Use Only:

Well #: G 298
 Aquifer: _____
 E-Log #: _____

State Law requires that this report be prepared by the license holder responsible for the work and filed with the Department at the above address within 30 days of completion of drilling of the well or borehole.

Well Owner Information <small>(Landowner if borehole is not for a water well)</small>	Well or Borehole Location
Owner Name: <u>Agway Farm</u>	Latitude: <u>33° 48' 35" N</u> Longitude: <u>90° 52' 03" W</u>
Mailing Address: <u>1241 S Bishop Rd</u>	Method of Lat/Long (check one): Conventional Survey _____, USGS quad _____, Hand-held GPS _____, Survey-grade GPS _____
<u>Cleveland MS</u>	MW SW NE 1/4 SE 1/4, Sec <u>23</u> T <u>23N</u> R <u>07W</u>
<u>Cleveland</u> MS <u>38732</u>	_____ Miles _____ of <u>Pace MS</u>
City _____ State _____ Zip Code _____	(Distance) _____ (Direction) _____ (Nearest Town)
Telephone No. (____) _____	

Well / Borehole Data

Date drilling started: _____ Date drilling completed: 9-1-20 Hole depth: 120 Hole diameter: 26

Location of the source of any surface water used for drilling: Next to well

Method of dosing and volume of Chlorine used in drilling and development: _____

Logs run (check all applicable): log run Electric Gamma Ray Density Sonic Neutron Other: _____

Name of organization running log(s): _____

Purpose of borehole (check one): Water Well Geotechnical/Geological Investigation Ground Source Heat Pump Seismic Survey Other (describe) fracturation

If drilling is not related to water well construction, skip the remainder of this block

Purpose of Well (check all applicable): Home Industrial Public Supply Irrigation Fish Culture

Other (describe): _____

If a flowing well, method of flow regulation: Valve _____ Other (describe) _____

Static Water Level: 42' feet above or below land surface Date measured: 9-1-20

(check one)

Method of measurement (check one) Steel tape Electric tape Air line Other (describe): _____

Well depth: 120 Well grouted to a depth of: 23 feet Type of grout (check one) Neat Cement Bentonite Mix

Casing length: 80 feet Casing diameter: 16 inches Type of casing: PVC

Screen length: 40 feet Screen diameter: 16 inches Type of screen: PVC

Screen slot size: 50 inches Setting depth: From 80-120 feet to 120 feet

Type of completion (check all applicable) gravel packed Underreamed Open hole Natural Development

Other (describe): _____

Top of lap pipe or reduction in casing: _____ feet

If telescoped or more than one screen, describe on next page

RECEIVED
 SEP 08 2020
 BY OLWR


For Office Use Only:
Well #: _____

Description of formations encountered must be provided for all wells and boreholes, unless specifically exempted by regulations

Description of Formations Encountered	From (depth)	To (depth)
Clay Hard	18'	26'
Clay Hard	26'	40'
Hard sand	40'	40'
Hard sand	40'	40'
Hard sand	40'	60'
Hard sand	60'	60'
Sand & gravel	60'	120'

County: _____
Permit #: _____


The sketch below only required for water wells
If well telescopes, show depths on sketch.

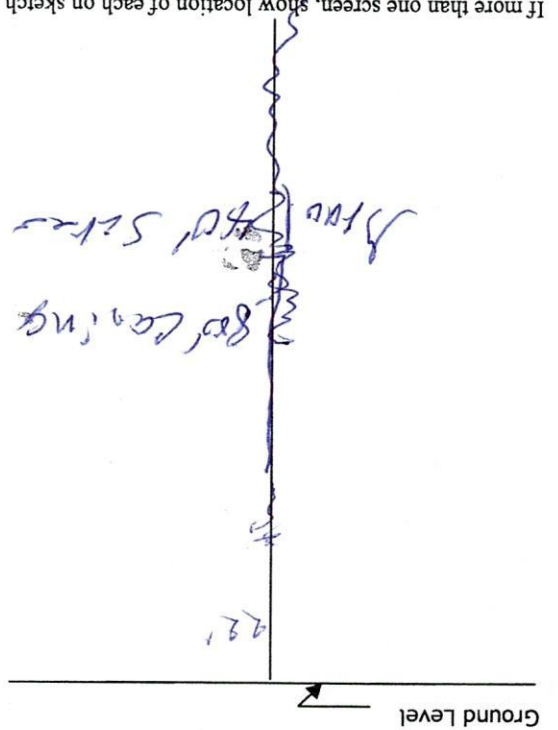

If more than one screen, show location of each on sketch

Sketch the property layout and include the following:

- 1) the well location
- 2) any permanent structures on the property that may aid in locating the well
- 3) any roads, power lines, or other items that may aid in locating the property and the well
- 4) north arrow

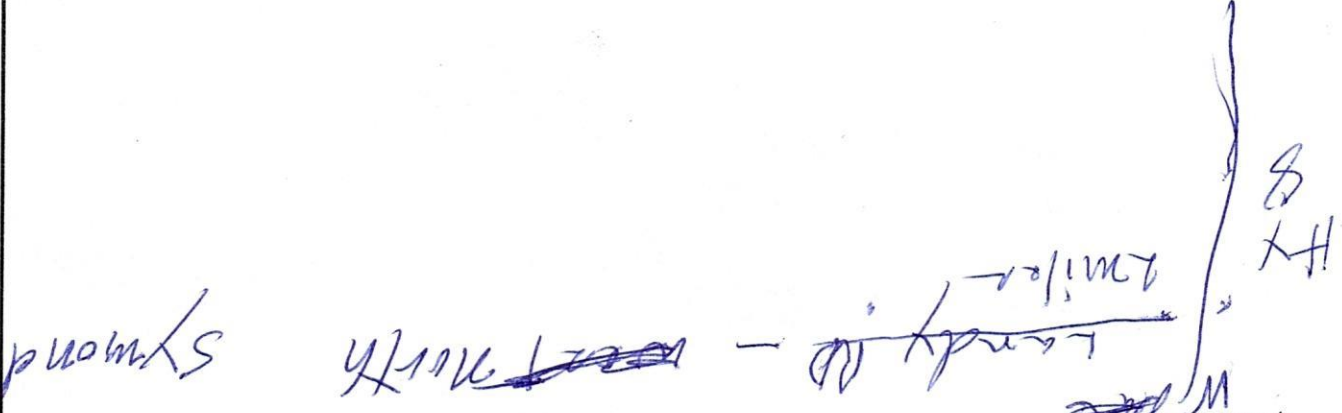

Landowner Name: Hoyt's Farm

I HEREBY CERTIFY that the well/borehole was drilled, constructed, and completed in accordance with all applicable requirements of the Mississippi Department of Environmental Quality and the Mississippi Department of Health regulations, if applicable, and state laws.

Print Name of Responsible Licensee and License No. Loft Drilling 289

Date 9-8-20

Signature of Licensee

[Handwritten signature]

STATE WELL REPORT

Part 2

Pump Installer's Completion Report
 Mississippi Department of Environmental Quality
 Office of Land and Water Resources
 P.O. Box 2309
 Jackson, MS 39225-2309
 (601)961-5210
 (601) 360-0535 (fax)

County: Bolivar
 Permit #: 289
 Driller: Cook Drilling
 Date completed: 9-1-20
Copy information from block on Part 1

For Office Use Only:

Well #: 6218-
 Aquifer: _____

This part of the report must be completed by a licensed water well contractor or a licensed pump installer. A copy of Part 1 of the report must be attached and both parts filed with the Department at the above address within 30 days of well completion.

Well Owner Information	Well Location
Owner Name: <u>Aguzzi Farms</u>	Latitude: <u>33°48'35" N</u> Longitude: <u>90°5'20" W</u>
Mailing Address: <u>1241 S. Bishop Rd</u>	Method of Lat/Long (check one): Conventional Survey _____, USGS quad _____, Hand-held GPS _____, Survey-grade GPS _____
<u>Cleveland</u> MS <u>38732</u>	<u>NW</u> ¼ <u>SW</u> ¼, Sec <u>30</u> T <u>23N</u> R <u>6W</u>
City State Zip Code	_____ Miles _____ of _____ (Distance) (Direction) (Nearest Town)
Telephone No. (____) _____	

Pump Type (check one)

Submersible Turbine Air Lift Centrifugal Flowing Well Jet Piston Rotary Other (describe): _____

Date Pump Installed: 9-1-20 Rated Pump Capacity: _____ Gallons Per Minute

Is This Pump (check one): New Repaired Replacement

Power Type (check one)

Electric Diesel Gasoline Natural Gas Tractor PTO Windmill Other (describe): _____

Horse Power Rating of Motor: 60 Setting Depth: 80' feet Number of Stages: 1

Pump Test Data for Non Flowing Well

Date Well Tested: _____ Duration of Pump Test (minimum 4 hours): _____ hours

Static Water Level (A): 42' Feet Below Land Surface Pumping Water Level (B): _____ Feet Below Land Surface

Drawdown [(B) - (A)]: _____ Feet Below Land Surface Test Pumping Rate: _____ Gallons Per Minute

Method of measurement (check one): Steel tape Electric tape Air line Other (describe): _____

Pump Test Data for Flowing Well

Measured shut in head: _____ feet.

Well yielded _____ GPM with a drawdown of _____ feet after _____ hours of pumping

Meter Installation

Meter Manufacturer: _____ Meter Serial Number: _____

Meter Model Number/Name: _____ Type of Meter: _____

Totalizer Register Unit and Multiplier Factor (AF x .001, gal x 1000, etc): _____

Installation Date: _____ Meter installed by: _____

Is This Meter (check one): New Repaired Replacement

Important: By submitting the above information you are certifying that this meter was installed to manufacturer standards. For agricultural wells, a list of approved meters is on the MDEQ website.

I HEREBY CERTIFY that the above statements are true to the best of my knowledge.

Gallen Williams 289 9-3-20 Gallen Williams
 Print Name of Pump Installer and License No. (if applicable) Date Signature of Pump Installer



Don R. Christy, PhD
Executive Director
P. O. Box 129
Stoneville, MS 38776
Tel.: (662) 686-7712
Fax: (662) 686-9078
www.ymd.org

Yazoo Mississippi Delta Joint Water Management District

August 31, 2020

RE: CONSTRUCTION NOTICE

Aguzzi Farms
1241 South Bishop Road
Cleveland, MS 38732

*Lundy Rd
Symond*

RE: Receipt for Notification of Construction of Replacement Well **MS-GW-51310**
which will be replacing GW-37004 well located at
Location: NE1/4 of the SE ¼ Section 25 Township 23N Range 07W County Bolivar
Latitude: 33.4835N Longitude -90.5203

Dear Aguzzi Farms:

This letter acknowledges your notification to the state that you intend to replace a previously permitted well in the Mississippi River Valley Alluvial Aquifer and that this replacement construction will meet the requirements for a groundwater replacement well specified in 11 Miss. Admin. Code Part 7, Chapter 1, Rule 1.4.F.1 (**see attached/back of page**). **Construction may begin immediately on your replacement well.**

Remember that you are still required to submit a permit application (enclosed) for the replacement well within 5 days of construction beginning. You are also required to properly decommission (plug and abandon) the replaced well within 180 days of the replacement well's construction.

A copy of this letter, or a water use permit for the replacement well, **must** be attached to the State Well Report submitted by your driller to MDEQ and they must also submit a copy to YMD, as specified in the Water Well Contractor regulations found in 11 Miss. Admin. Code Part 7, Chapter 2, Rule 2.9.

If you have any questions, please call YMD at 662-686-7712.

Sincerely,

Dillard Melton, Jr.
Permitting Director

RECEIVED
SEP 0 8 2020
BY OLWR
RECEIVED
SEP 0 8 2020
BY OLWR