

**BOLIVAR**  
**H-63** MISSISSIPPI BOARD OF WATER COMMISSIONERS  
**8-12-65** WATER WELL DRILLERS LOG

Date: 8/12, 1965, Driller: Delta Well Supply Co County: Bolivar  
 (Name)

(1) Owner of Land: J. R. Smith III  
 (Name)  
Merigold, Miss.  
 (Address)

(2) Location: 1/4, 1/4, Sec. 30 T33R5  
2 miles So West of Merigold  
 (distance) (direction) (Nearest Town)

(3) Topography:  (Level)  
 (Flat)  (Hilly)

(4) Purpose of Well: Irrigation  
 (Domestic Irrigation, Municipal, Industrial, Other)

| Description & Color of Materials<br>Sand, Clay, Red Clay, Shell, etc. | Thick-<br>ness<br>Feet | Depth<br>Feet |
|---|------------------------|---------------|
| <u>Top soil</u>   | <u>26</u>              |               |
| <u>Sand</u>   | <u>42</u>              | <u>68</u>     |
| <u>Coarse sand</u>  | <u>29</u>              | <u>97</u>     |
| <u>Rock</u>   | <u>1</u>               | <u>98</u>     |
| <u>Coarse sand &amp; gravel</u>                                       | <u>24</u>              | <u>122</u>    |

Information upon completion of well:

(1) Diameter 12 inches.

(2) Total Depth 122 feet.

(3) Water Level 23 feet below top of ground.

(4) Cased to \_\_\_\_\_, Size \_\_\_\_\_

(5) Screen: Size 12, Length 38

(6) Were any formations sealed against pollution?  
 \_\_\_\_\_ yes, \_\_\_\_\_ no.


If YES depth of formation \_\_\_\_\_  
 Why \_\_\_\_\_

Drillers Remarks: \_\_\_\_\_

Yield in G. P. M.: 2000

Type power: Tractor

Crops Irrigated & Acreage: Cotton & Beans

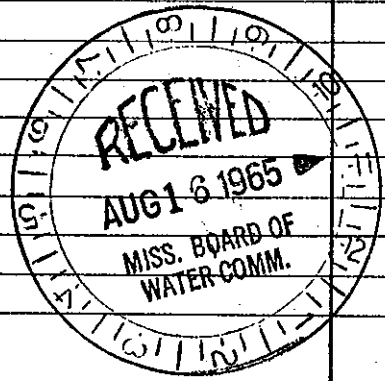

(Use Back Side)

Well No.

Mail this copy to Board of Water Commissioners 429 Miss. St. Jackson, Miss.