

BOLIVAR

MISSISSIPPI BOARD OF WATER COMMISSIONERS

H-64

CODED

11/24/65
JML 648

4-25-59 WATER WELL DRILLERS LOG

Date: April 25, 1959, Driller: Layne-Central Company County Bolivar

(Name)

(1) Owner of Land: Ray & Myers
(Name)
Cleveland, Mississippi
(Address)

(2) Location: 1/4, 1/4, Sec. 17 T23R15,
3 miles west, of Cleveland
(distance) (direction) (Nearest Town)

(3) Topography: flat
(Hilly) (Flat) (Level)

(4) Purpose of Well: irrigation
(Domestic Irrigation
Municipal, Industrial, Other)

Description & Color of Materials Sand, Clay, Red Clay, Shell, etc.	Thick- ness Feet	Depth Feet
<u>Clay</u>	<u>12</u>	<u>12</u>
<u>Sand</u>	<u>50</u>	<u>62</u>
<u>Coarse sand & gravel</u>	<u>45</u>	<u>107</u>
<u>Blue clay</u>	<u>2</u>	<u>109</u>

CODED

Information upon completion of well:

- (1) Diameter 16 inches.
- (2) Total Depth 107 feet.
- (3) Water Level 18' feet below top of ground.
- (4) Cased to 57'9", Size 16"
- (5) Screen: Size 16", Length 50'
- (6) Were any formations sealed against pollution?
no yes, no no.


If YES depth of formation _____

Why _____

Drillers Remarks: _____

2800 GPM.

Electric power.

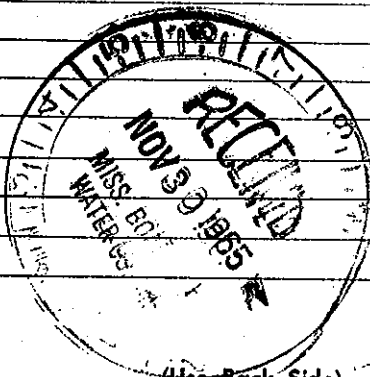

Well No. _____

(Use Back Side)

Mail this copy to Board of Water Commissioners 429 Miss. St. Jackson, Miss