

H66

**BOLIVAR**  
~~9-11-75~~  
7-1-60

# WATER WELL DRILLERS LOG

H-300

Date: 7/1, 1960, Driller: Layne-Central Co., Bolivar  
(Name)

**CODED**

(1) Owner of Land: Roger Hall  
(Name)  
Merigold, Mississippi  
(Address) 28 23 N 5 W  
19 22 N 5 W

(2) Location: 1/4, 1/4, Sec 19 T. R.  
4 miles North of Cleveland  
(distance) (direction) (Nearest Town)

(3) Topography: X  
(Hilly) (Flat) (Level)

(4) Purpose of Well: Domestic  
- Domestic, Irrigation, Municipal, Industrial, Other

Description & Color of Materials Sand, Clay, Red Clay, Shell, etc.	Thick- ness Feet	Depth Feet
Sandy Clay	15	15
Blue Clay	31	46
Fine sand	24	70
Coarse sand	20	90
Coarse sand & gravel	32	122
Clay	26	148
Sandy shale	59	207
Fine sand	128	335
Sandy & shale	45	380
Shale	18	398
Sand & streaks of shale	90	488
Shale	15	503
Clay	95	598
Sand, sts. of shale	15	613
Sand	92	705
Shale	5	710

**CODED**

Information upon completion of well:

(1) Diameter 4x3 inches.


(2) Total Depth 710 feet.

(3) Water Level 20'-9" feet below top of ground.

(4) Cased to 671, Size 4x3

(5) Screen: Size 3", Length 31'

(6) Were any formations sealed against pollution?  
X yes, no. Packer  
If YES depth of formation Above screen  
Why To eliminate all other formations.  
Drillers Remarks:

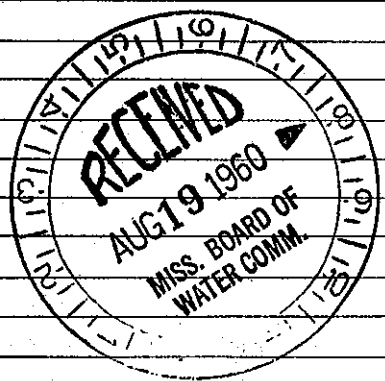

(Use Back Side)

Well No.

Mail this copy to Board of Water Commissioners 429 Miss. St. Jackson. Miss