

BOLIVAR

H79

11-6-75

MISSISSIPPI BOARD OF WATER COMMISSIONERS
416 North State Street
Jackson, Mississippi 39201

CODED

WATER WELL DRILLERS LOG

11-6 1975 Dyer-Sullivan BOLIVAR
date well completed firm name county well located

LANDOWNER: RONALD THORNTON

description of formations encountered

from to

Mound Bayou

MISS.

(mailing address)

CLAY
FINE SAND
SAND & GRAVEL
0 14
14 37
37 114

WELL LOCATION:

sec. 1 T 23 N R 5 W
3 miles E of Mound Bayou
(distance) (direction) (nearest town)

elw. 135 CODED

WELL PURPOSE: IRRIGATION
(home, irrigation, municipal, industrial)


WELL COMPLETION DATA:

- (1) diameter (inches) 16
- (2) total depth (feet) 114'
- (3) static water level (feet) 12 below above top of ground.
- (4) casing BIK. INST 74'
(material) (depth)
16" if telescope see back.
(size)
- (5) screen 40' 74'
(length) (depth to top)
16" DOOR-GRAND FOUNTAIN
(size) (material)
- (6) pump 60 9700
(HP) (yield gpm)
Diesel
(type power)
- (7) electric log NO
(yes or no)

(organization running log)

(8) how well bottom plugged PLATE

DRILLERS REMARKS:

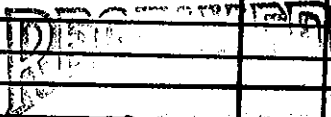

DEC 22 1975

MISS. BD. OF WATER COMM