

CODED

MISSISSIPPI  
BOARD OF WATER COMMISSIONERS  
416 North State Street  
Jackson, Mississippi 39201

WATER WELL DRILLERS LOG

Bolivar  
H 82  
5-67

5/1 1967 date well completed  
D. Starbuck & Supply Co. firm name  
Bolivar county well located

LANDOWNER:  
L. A. Peoples  
Merigold miss  
(mailing address)

description of formations encountered	from	to
Top Clay		33
Fine sand & clay	35	70
sand & gravel	75	95
clay	29	
sand & gravel	18	115

WELL LOCATION:  
sec. 17 T. 23 N R. 5 E  
S W  
1 miles West Merigold  
(distance) (direction) (nearest town)

WELL PURPOSE: Irrigation  
(home, irrigation, municipal, industrial)

WELL COMPLETION DATA:

(1) diameter (inches) 16

(2) total depth (feet) 115

(3) static water level (feet) 21 below above top of ground.

(4) casing steel 75 (material) (depth)  
16 (size) if telescope see back.

(5) screen 40 75 (length) (depth to top)  
16 steel (size) (material)


(6) pump 50 2500 (HP) (yield gpm)  
Elec (type power)

(7) electric log (yes or no)

(organization running log)

(8) how well bottom plugged Concrete

CODED.

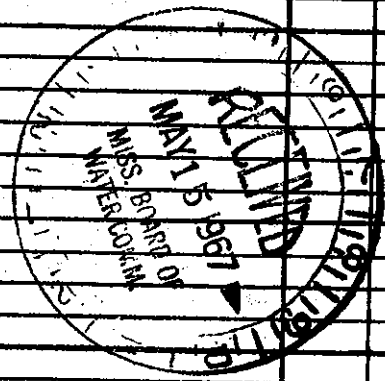

DRILLERS REMARKS: