

Bolivar
1483
7-67

Bolivar

MISSISSIPPI BOARD OF WATER COMMISSIONERS

WATER WELL DRILLERS LOG

Date: July 10, 1967, Driller: Luther Rattiff County Bolivar
(When well drilled) (Name) (Where well is located)


(1) Owner of Land: J. E. Pimple
(Name)
Merigold Miss.
(Address)
 (2) Location: NW 1/4, SW 1/4, Sec. 20 T23R5
1 miles west of Merigold
(distance) (direction) (Nearest Town)
 (3) Topography: (Hilly) (Flat) (Level)
 (4) Purpose of Well: Domestic
(Domestic Irrigation Municipal, Industrial, Other)

Description & Color of Materials <small>Sand, Clay, Red Clay, Shell, etc.</small>	Thick- ness Feet	Depth Feet
Top soil	23	23
Sand & gravel	180	167
Shale	80	247
Sand	80	327
Shale	20	347
Sand	90	427
Shale & sand streak	120	547
Sand	140	687
Shale	10	697
Sand	40	737

Information upon completion of well:

(1) Diameter 4" x 2 1/2" inches.
 (2) Total Depth 727 feet.
 (3) Water Level 27 feet below top of ground.
 (4) Cased to 727, Size _____
 (5) Screen: Size 2 1/2, Length 20
 (6) Were any formations sealed against pollution?
 _____ yes, _____ no.

CODED

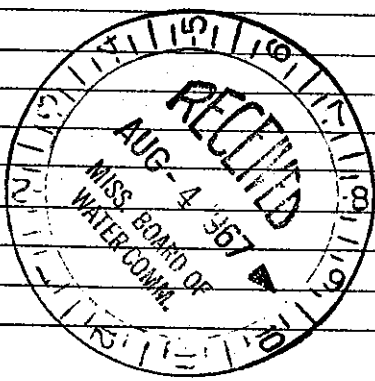

If YES depth of formation _____
 Why _____
 Drillers Remarks: _____
 Yield in gpm: _____
 Size pump: _____
 Type power: _____

Mail this copy to Board of Water Commissioners 429 Miss. St. Jackson, Miss.