

CODED

CODED

BOLIVAR

H 84

1-68

MISSISSIPPI
BOARD OF WATER COMMISSIONERS
416 North State Street
Jackson, Mississippi 39201

WATER WELL DRILLERS LOG

Jan 25 1968
date well completed

Luther Patton
firm name

BOLIVAR
county well located

LANDOWNER: Alvin Horton

Rt # 1

Morgan, Miss
(mailing address)

WELL LOCATION:

sec 37 T 23 N R 5 E
S
5 miles SE of Morgan
(distance) (direction) (nearest town)

WELL PURPOSE:

(home, irrigation, municipal, industrial)


WELL COMPLETION DATA:

- (1) diameter (inches) 4 1/2"
- (2) total depth (feet) 618
- (3) static water level (feet) 30 below above top of ground.
- (4) casing Steel, 6 1/2"
(material) (depth)
4 1/2" If telescope see back.
(size)
- (5) screen 20', 598
(length) (depth to top)
2", Strainer steel
(size) (material)
- (6) pump 1, 20
(HP) (yield gpm)
Elec
(type power)
- (7) electric log (yes or no)
- (organization running log)
- (8) how well bottom plugged BWU

description of formations encountered

from to

3-23 Top Soil
23-47 Sand
47-67 Sand & Gravel
67-87 Sand & Gravel
87-107 Sand & Gravel
107-127 Sand & Clay
127-147 Clay
147-167 Clay & Sand
167-187 Sand
187-207 Sand
207-227 Clay
227-247 Clay & Sand
247-267 Clay
267-287 Clay
287-307 Clay & Sand
307-327 Clay & Sand
327-347 Clay & Sand
347-367 Clay & Sand
367-387 Sand
387-407 Sand
407-427 Sand & Shale
427-447 Sand & Shale
447-467 Sand & Shale
467-487 Sand & Shale
487-507 Sand
507-527 Sand
527-547 Sand
547-567 Sand
567-587 Sand
587-607 Sand
607-618 Sand

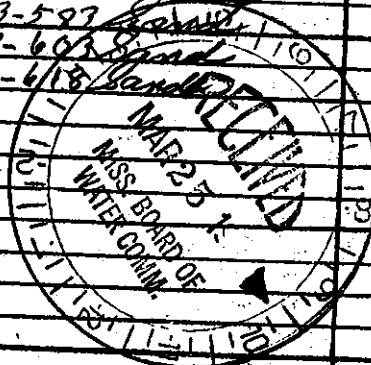

DRILLERS REMARKS: