

CODED

CODED

MISSISSIPPI BOARD OF WATER COMMISSIONERS  
416 North State Street  
Jackson, Mississippi 39201

WATER WELL DRILLERS LOG

BOLIVER  
H 86  
3-68

3/30  
date well completed

1968 Delta Well & Supply Co  
firm name

Bolivar  
county well located

LANDOWNER:  
Francis Bell  
PO, Box 428 Mound Bayou.  
(mailing address)

description of formations encountered	from	to
Clay	0	16
soil	16	143
Rock	143	144
hard fine	144	168
Clay shale	168	438
soil	438	479
Clay	479	500
hard fine	500	541
Clay	541	633
slat & sand streak	633	707
Clay hard	707	744
soil	744	783

WELL LOCATION:  
sec. 2 T. 23 N R. 5 W  
1 1/2 miles East Mound  
(distance) (direction) (County, Miss.)

WELL PURPOSE:  
Domestic  
(home, irrigation, municipal, industrial)

WELL COMPLETION DATA:

(1) diameter (inches) 4 1/2

(2) total depth (feet) 76.3

(3) static water level (feet) 26 below above top of ground.

(4) casing galv. pipe (material) (depth) (size) if telescope see back.


(5) screen 20 (length) (depth to top) 2 stainless steel (size) (material)

(6) pump 1/2 (HP) 20 (yield gpm) elec (type power)

(7) electric log No (yes or no) (organization running log)

(8) how well bottom plugged B-F plug

CODED

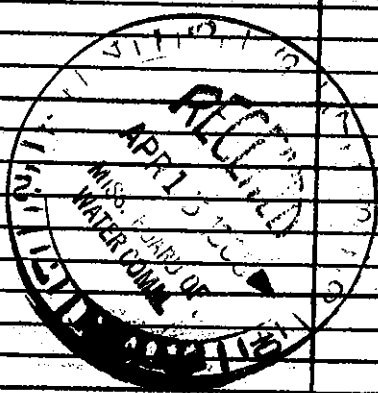

DRILLERS REMARKS: