

CODED

Belivar

H 93

9-68

MISSISSIPPI  
 BOARD OF WATER COMMISSIONERS  
 416 North State Street  
 Jackson, Mississippi 39201

CODED

WATER WELL DRILLERS LOG

9/4  
date well completed

Delta Well & Supply  
firm name

Belivar  
county well located

LANDOWNER:

Mech. Wess pipe line  
Co. - Cleveland Miss  
(mailing address)

description of formations encountered

from to

Gravel	0	43
Sand	43	67
" gravel	67	143
Clay	143	223
Clay with sand	223	443
Shale	443	463
" + clay	463	583
sand rock	583	585
" shale	585	703
Sand Med.	703	772

WELL LOCATION:

sec 33 T 23 N R 5 W  
2 miles S.W. of Merigold  
(distance) (direction) (nearest town)

WELL PURPOSE:


sand  
(home, irrigation, municipal, industrial)

WELL COMPLETION DATA:

- (1) diameter (inches) 4 X 2
- (2) total depth (feet) 756
- (3) static water level (feet) 29 below top of ground.
- (4) casing Gal. steel (material) (depth) (size) If telescope see back.
- (5) screen 20 (length) (depth to top) 2 stainless steel (size) (material)
- (6) pump 1 (HP) 20 (yield gpm) Elec (type power)
- (7) electric log (yes or no)
- (organization running log)
- (8) how well bottom plugged R.P.V.

Bottom 756  
CODED

CODED

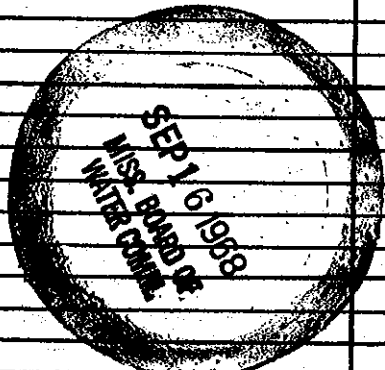

DRILLERS REMARKS: