

Bolivar MISSISSIPPI BOARD OF WATER COMMISSIONERS

~~Q.M. 75~~ H 94

5-66

WATER WELL DRILLERS LOG

CODED

Date: 5/21, 1966, Driller: Delta Well Supply Co County Bolivar
(Name)

(1) Owner of Land: <u>Rodger Hall</u> <small>(Name)</small>	Description & Color of Materials Sand, Clay, Red Clay, Shell, etc.	Thick- ness Feet	Depth Feet
<u>Cleveland</u> <small>(Address) 1279, 2029, 2023 23 St</small>	<u>top soil</u>	<u>6</u>	
(2) Location: <u>1/4</u> , <u>1/4</u> , Sec. <u>28</u> <u>T2R5</u>	<u>sand clay</u>	<u>28</u>	<u>34</u>
<u>2</u> miles <u>South</u> of <u>Missigall</u> <small>(distance) (direction) (Nearest Town)</small>	<u>Fine sand</u>	<u>18</u>	<u>52</u>
(3) Topography: <u>Level</u> <small>(Hilly) (Flat) (Level)</small>	<u>clay & sand</u>	<u>10</u>	<u>62</u>
(4) Purpose of Well: <u>Irrigation</u> <small>(Domestic Irrigation Municipal, Industrial, Other)</small>	<u>Coarse sand & gravel</u>	<u>50</u>	<u>112</u>

Information upon completion of well:

(1) Diameter 12 inches.

(2) Total Depth 112 feet.

(3) Water Level 22 feet below top of ground.

(4) Cased to _____, Size _____

(5) Screen: Size 12, Length 36

(6) Were any formations sealed against pollution?
 _____ yes, _____ no.

If YES depth of formation _____


Why _____

Drillers Remarks:
1650 S.P.M.
Tractor Powered

#1 well

CODED

112
36
76

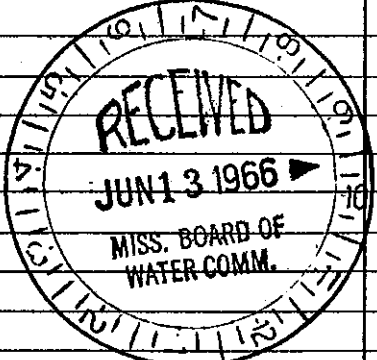

Well No.

(Use Back Side)

Mail this copy to Board of Water Commissioners 429 Miss. St. Jackson, Miss.