

Bolivar
H 117
6-12-81

MISSISSIPPI DEPARTMENT OF NATURAL RESOURCES
 Bureau of Land and Water Resources
 Southport Mall
 P.O. Box 10631
 Jackson, Mississippi 39209
CODED
WATER WELL DRILLERS LOG

June 12 1981 Delta Well & Supply Bolivar County
 date well completed firm name county well located

LANDOWNER:
Roger Morris
Mound Bayou Miss.
 (mailing address)


WELL LOCATION:
 sec. 13 T. 23 N. R. 5 E
5 miles NE of Merigold
 (distance) (direction) (nearest town)

WELL PURPOSE: Irrigation
 (home, irrigation, municipal, industrial)

WELL COMPLETION DATA:
 (1) diameter (inches) 16"
 (2) total depth (feet) 117
 (3) static water level (feet) 26 below top of ground.
 (4) casing steel (material) (depth) _____
 (size) if telescope see back.
 (5) screen 40' (length) (depth to top) _____
16" (size) steel (material)
 (6) pump 60 (HP) 3150 (yield gpm)
Elec. (type power)
 (7) electric log no (yes or no)
 (organization running log) _____
 (8) how well bottom plugged Steel Plate

description of formations encountered	from	to
<u>Top soil</u>	<u>0</u>	<u>24</u>
<u>clay</u>	<u>24</u>	<u>45</u>
<u>fine sand</u>	<u>45</u>	<u>58</u>
<u>course sand</u>	<u>58</u>	<u>75</u>
<u>Course sand & gravel</u>	<u>75</u>	<u>117</u>
<u>Bottom 117</u>		

CODED

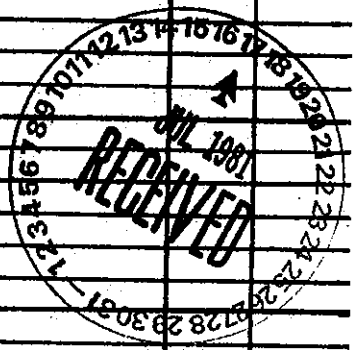

DRILLERS REMARKS: