

BOLIVAR  
 CL-1818  
H 121  
4-26-81

MISSISSIPPI DEPARTMENT OF NATURAL RESOURCES  
 Bureau of Land and Water Resources  
 Southport Mall  
 P.O. Box 10631  
 Jackson, Mississippi 39209  
**WATER WELL DRILLERS LOG**

Gw 7125  
 NW/NW, Sec. 36  
 Elev. 140

**CODED**

4-26-81 19 LAYNE-CENTRAL COMPANY BOLIVAR  
 date well completed film name county well located


LANDOWNER:	description of formations encountered	from	to
Mrs. Roberta Wiggins			
Renova, MS	fine sand	14	27
(mailing address)	med. sand	27	32
<b>WELL LOCATION:</b>	coarse sand-pea gravel	32	42
36 25 T 23 N R 5 E	coarse sand-pea gravel	42	62
4 miles N.E. of <i>Clarks</i>	coarse sand-pea gravel	62	72
(distance) (direction) (nearest town)	coarse sand-gravel	72	102
	gravel	102	122

**WELL PURPOSE:** irrigation  
 (home, irrigation, municipal, industrial)

**WELL COMPLETION DATA:**

- (1) diameter (inches) 32"
- (2) total depth (feet) 122'
- (3) static water level (feet) 29 below above top of ground.
- (4) casing steel 82'  
 (material) (depth)  
16"  
 (size) if telescope see back.
- (5) screen 40' 82'  
 (length) (depth to top)  
16" st. steel  
 (size) (material)
- (6) pump 40 2000  
 (HP) (yield gpm)  
EL6C  
 (type power)
- (7) electric log no  
 (yes or no)  
 (organization running log)
- (8) how well bottom plugged st. plate

**CODED**

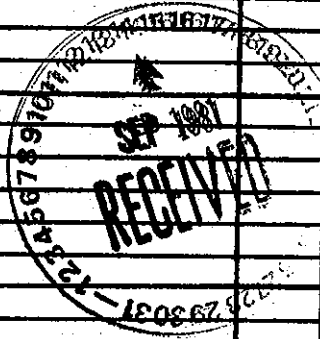

**DRILLERS REMARKS:**