

MISSISSIPPI DEPARTMENT OF NATURAL RESOURCES

Bureau of Land and Water Resources

Southport Mall

P.O. Box 10631

Jackson, Mississippi 39202

WATER WELL DRILLERS' LOG

CODED

Bolivar
 CL-1996 H122
7-27-81


7-27 1981 LAYNE-CENTRAL CO. BOLIVAR
 date well completed firm name county well located

| LANDOWNER: | description of formations encountered | from | to |
|---|---------------------------------------|------|-----|
| Zumbro Plantation | | | |
| Merigold, MS (mailing address) | fine sand | 14 | 38 |
| | c. sand | 38 | 42 |
| WELL LOCATION: sec. <u>34</u> T. <u>23</u> N R. <u>5</u> E <u>3</u> miles <u>N</u> of <u>Bolivar</u> (distance) (direction) (nearest town) | c. sand | 42 | 52 |
| | c. sand | 52 | 62 |
| | c. sand - pea gr. | 62 | 82 |
| | c. sand - gravel | 82 | 92 |
| | c. sand & gravel | 92 | 119 |

WELL PURPOSE: irrigation
 (home, irrigation, municipal, industrial)

- WELL COMPLETION DATA:
- (1) diameter (inches) 22"
 - (2) total depth (feet) 119'
 - (3) static water level (feet) 29 below top of ground.
 - (4) casing steel 79'
 (material) (depth)
8"
 (size) if telescope see back.
 - (5) screen 40' 79'
 (length) (depth to top)
8" PVC
 (size) (material)
 - (6) pump 20 1100
 (HP) (yield gpm)
ELEC
 (type power)
 - (7) electric log no
 (yes or no)
 (organization running log)
 - (8) how well bottom plugged st. plate

CODED

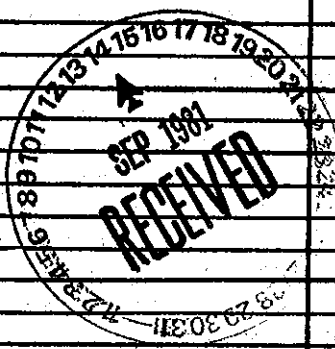

DRILLERS REMARKS: