

FEB-13-2007 08:51 From: MID SOUTH WATER

6628431717

To: 601 360 0535

P.2/3

Part 2 never received 3/13

#566
②

County: Bolivar
 Permit #: GW41506
 Driller: Shane Partridge
 Date drilling completed: 1-25-07

State Well Report
Part 1 - Driller's Log

Mississippi Department of Environmental Quality
 Office of Land and Water Resources
 P.O. Box 10631
 Jackson, MS 39289-0631
 (601)961-5210
 (601)354-6938 (fax)

For Office Use Only:
 Aquifer: _____
 Well #: H-166
 L.S. Elevation: _____
 B-log #: _____

State Law requires that this report be prepared by the license holder responsible for the work and filed with the Department at the above address within 30 days of completion of drilling of the well or borehole.

<p>Information on Well Owner (Landowner if borehole is not for a water well)</p> <p>Owner Name: <u>Fiorenelli Brothers, J.V.</u> Mailing Address: <u>P.O. Box 1594</u> <u>Cleveland MS 39732</u> City State Zip Code Telephone No. <u>(662) 515-8340</u></p>	<p>Well or Borehole Location</p> <p>Latitude: <u>N33° 51' 26.5"</u> Longitude: <u>W 90° 45' 13.1"</u> Method of Lat/Long (circle one): <u>27</u> Conventional Survey, <u>13</u> USGS quad, <u>Hand-held GPS, Survey-grade GPS</u> <u>NE 1/4, SE 1/4, Sec 7</u> Twn <u>23N</u> Rng <u>5W</u> Distance <u>2.12</u> Miles <u>N.W.</u> of <u>MILERSBURG</u></p>
--	--

Well / Borehole Data

Date drilling started: 1-25-07 Date drilling completed: 1-25-07 Hole depth: 122 Hole diameter: 24"

Location of the source of any surface water used for drilling: OLD WOOD
 Method of dosing and volume of Chlorine used in drilling and development: _____

Logs run (circle all applicable): No log run Electric Gamma Ray Density Sonic Neutron Other: _____
 Name of organization running log(s): _____

Purpose of borehole (check one): Water Well Geotechnical/Geological Investigation _____ Ground Source Heat Pump _____
 Seismic Survey _____ Other (describe) _____

If drilling is not related to water well construction, skip the remainder of this block

Purpose of Well (check one): Home _____ Industrial _____ Public Supply _____ Irrigation Fish Culture _____ Other: _____

If flowing well, method of flow regulation: Valve _____ Other (describe) _____

Static Water Level: 41 feet above or below (circle one) land surface Date measured: _____

Method of Measurement (circle one) steel tape electric tape air line other: _____

Well depth: 120 Well grouted to a depth of 10 feet Type of grout (circle one): Neat Cement Bentonite Mix

Casing length: 80 feet Casing diameter: 16 inches Type of casing: PVC

Screen length: 40 feet Screen diameter: 16 inches Type of screen: PVC

Screen slot size: .050 inches Setting depth: From 80 feet to 120 feet

Type of completion (circle all applicable): Gravel packed Underreamed Telescoped Open hole Natural Development
 Other (describe): _____

Top of lap pipe or reduction in casing: _____ feet. *If telescoped or more than one screen, describe on next page*

Form: OLWR-SWR-1A


RECEIVED
 FEB 13 2007
 BY: OLWR

FEB-13-2007 08:51 From:MID SOUTH WATER 6628431717 To:601 360 0535 P.3/3

H-166

The sketch below only required for water wells.


If well telescopes, show depths on sketch.

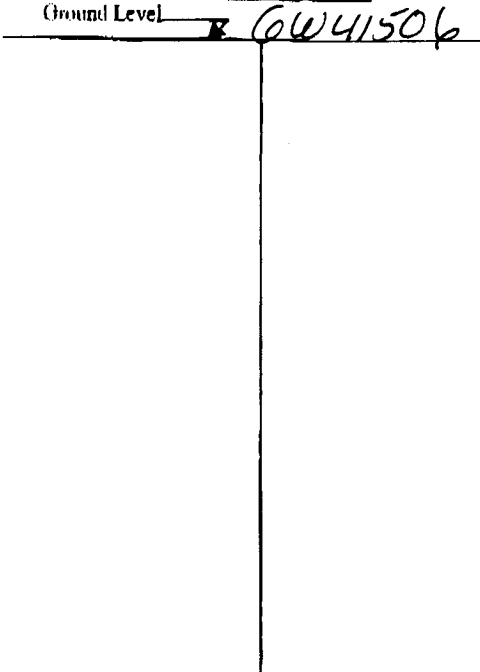

Description of formations encountered must be provided for all wells and boreholes, unless specifically exempted by regulations.

Description of Formations Encountered	From (depth)	To (depth)
Clay	Ground Level	12
Fine Sand	12	22
Fine Sand	22	27
Medium Sand	27	32
Coarse Sand & Gravel	32	42
Coarse Sand & Clay	42	46
Medium Sand	46	52
Medium Sand	52	62
Medium Sand	62	72
Medium Sand	72	78
Coarse Sand & Gravel	78	82
Coarse Sand & Gravel	82	92
Coarse Sand & Gravel	92	102
Coarse Sand & Gravel	102	112
Coarse Sand & Gravel	112	122

If more than one screen, show location of each on sketch

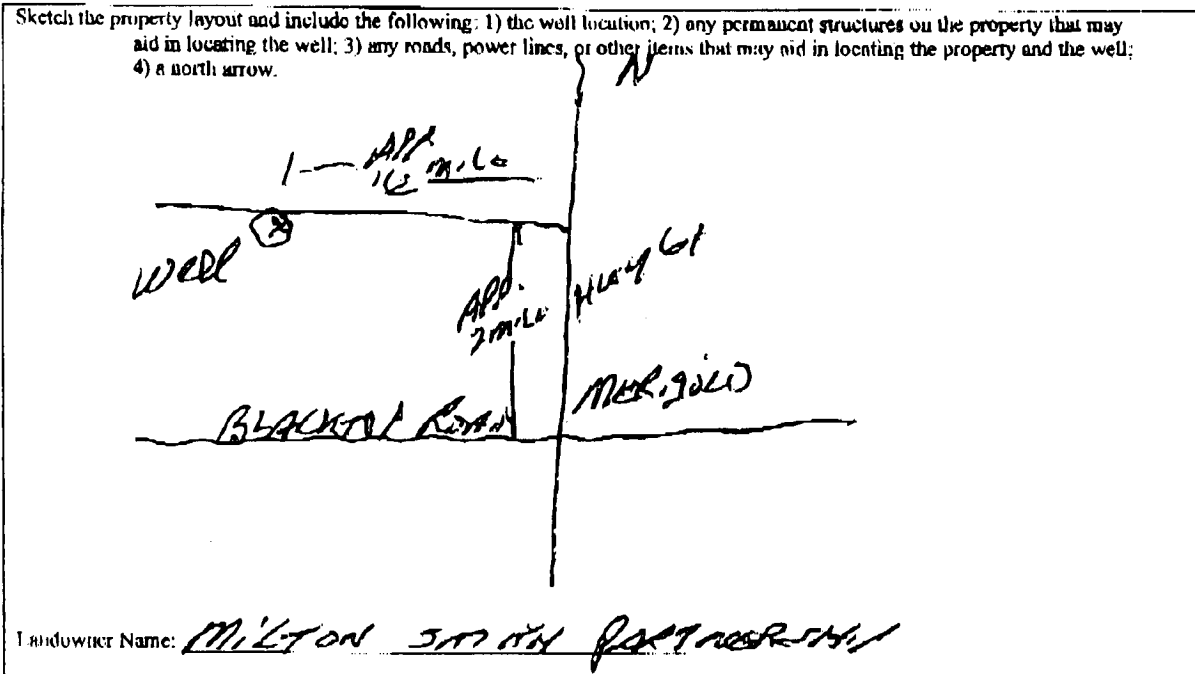

Form: OLWR-SWR-1A

I certify that the well/borehole was drilled, constructed, and completed in accordance with all applicable requirements of the Mississippi Department of Environmental Quality and the Mississippi Department of Health regulations, if applicable, and state laws.

Thomas G. Christman 0-703

2-13-07

[Signature]

Signature of Licensee

RECEIVED

FEB 13 2007

BY: OLWR