

# STATE WELL REPORT

## Part 1

### Driller's Log

Mississippi Department of Environmental Quality  
Office of Land and Water Resources  
P.O. Box 2309  
Jackson, MS 39225-2309  
(601)961-5210  
(601)360-0535 (fax)

### For Office Use Only:

Well #: H220  
Aquifer: \_\_\_\_\_  
E-Log #: \_\_\_\_\_

County: Bolivar  
Permit #: GW-49851 ✓  
Driller: Chad Mattox  
Date drilling completed: 6/13/17

*State Law requires that this report be prepared by the license holder responsible for the work and filed with the Department at the above address within 30 days of completion of drilling of the well or borehole.*

Well Owner Information <small>(Landowner if borehole is not for a water well)</small>	Well or Borehole Location
Owner Name: <u>V Moore Farms LLC</u>	Latitude: <u>33 51 42</u> Longitude: <u>90 43 54</u>
Mailing Address: <u>5 Colton Drive</u>	Method of Lat/Long (check one): Conventional Survey _____
<u>Merigold</u> <u>MS</u> <u>38759</u>	USGS quad _____, Hand-held GPS <input checked="" type="checkbox"/> , Survey-grade GPS _____
City State Zip Code	<u>NE</u> <u>NE</u> <u>08</u> <u>23N</u> <u>05W</u>
Telephone No. (____) _____	<u>1/2</u> Miles <u>S</u> of <u>Mound Bayou</u>
	(Distance) (Direction) (Nearest Town)

Well / Borehole Data
Date drilling started: <u>6/13/17</u> Date drilling completed: <u>6/13/17</u> Hole depth: <u>118</u> Hole diameter: <u>22"</u>
Location of the source of any surface water used for drilling: <u>NEARBY ditch</u>
Method of dosing and volume of Chlorine used in drilling and development: _____
Logs run (circle all applicable): <input checked="" type="checkbox"/> No log run <input type="checkbox"/> Electric <input type="checkbox"/> Gamma Ray <input type="checkbox"/> Density <input type="checkbox"/> Sonic <input type="checkbox"/> Neutron Other: _____
Name of organization running log(s): _____
Purpose of borehole (circle one): <input checked="" type="radio"/> Water Well <input type="radio"/> Geotechnical/Geological Investigation <input type="radio"/> Ground Source Heat Pump
<input type="radio"/> Seismic Survey <input type="radio"/> Other (describe) _____
<i>If drilling is not related to water well construction, skip the remainder of this block</i>
Purpose of Well (circle all applicable): Home <input type="radio"/> Industrial <input type="radio"/> Public Supply <input type="radio"/> <input checked="" type="radio"/> Irrigation <input type="radio"/> Fish Culture
Other (describe): _____
If a flowing well, method of flow regulation: Valve _____ Other (describe) _____
Static Water Level: <u>26</u> feet [above or <input checked="" type="radio"/> below] land surface Date measured: <u>6/13/17</u>
Method of measurement (circle one): <input checked="" type="radio"/> Steel tape <input type="radio"/> Electric tape <input type="radio"/> Air line Other (describe): _____
Well depth: <u>118</u> Well grouted to a depth of: <u>10</u> feet Type of grout (circle one): Neat Cement <input checked="" type="radio"/> Bentonite <input type="radio"/> Mix
Casing length: <u>78</u> feet Casing diameter: <u>12"</u> inches Type of casing: <u>PVC</u>
Screen length: <u>40</u> feet Screen diameter: <u>12"</u> inches Type of screen: <u>PVC</u>
Screen slot size: <u>.032</u> inches Setting depth: From <u>78</u> feet to <u>118</u> feet
Type of completion (circle all applicable): <input checked="" type="radio"/> Gravel packed <input type="radio"/> Underreamed <input type="radio"/> Open hole <input type="radio"/> Natural Development
Other (describe): _____
Top of lap pipe or reduction in casing: _____ feet
<i>If telescoped or more than one screen, describe on next page</i>



# STATE WELL REPORT

## Part 2

**Pump Installer's Completion Report**  
 Mississippi Department of Environmental Quality  
 Office of Land and Water Resources  
 P.O. Box 2309  
 Jackson, MS 39225-2309  
 (601)961-5210  
 (601) 360-0535 (fax)

County: BOLEVAR  
 Permit #: GW-49851  
 Driller: Chad Motor  
 Date completed: 6-13-17  
*Copy information from block on Part 1*

**For Office Use Only:**

Well #: H220  
 Aquifer: \_\_\_\_\_

RECEIVED  
 AUG 29 2017  
 BY OLWR

*This part of the report must be completed by a licensed water well contractor or a licensed pump installer. A copy of Part 1 of the report must be attached and both parts filed with the Department at the above address within 30 days of well completion.*

Well Owner Information	Well Location
Owner Name: <u>U MOORE FARMS</u>	Latitude: <u>33°51.419</u> Longitude: <u>90°43.541</u>
Mailing Address: <u>5 COLTON DR.</u>	Method of Lat/Long (check one): Conventional Survey <input checked="" type="checkbox"/> USGS quad _____, Hand-held GPS _____, Survey-grade GPS _____
<u>MERIGOLD</u> <u>MS</u> <u>38759</u> City State Zip Code	<u>NE</u> ¼ <u>NE</u> ¼, Sec <u>08</u> T <u>23N</u> R <u>05W</u>
Telephone No: <u>(602) 719-5083</u>	<u>3/4</u> Miles <u>S</u> of <u>MONROE BAYOU</u> (Distance) (Direction) (Nearest Town)

**Pump Type (circle one)\***

Submersible  Turbine \_\_\_\_\_ Air Lift \_\_\_\_\_ Centrifugal \_\_\_\_\_ Flowing Well \_\_\_\_\_ Jet \_\_\_\_\_ Piston \_\_\_\_\_ Rotary \_\_\_\_\_ Other (describe): \_\_\_\_\_

Date Pump Installed: 7-27-17 Rated Pump Capacity: 1400 Gallons Per Minute

Is This Pump (circle one): New \_\_\_\_\_ Repaired \_\_\_\_\_ Replacement \_\_\_\_\_

**Power Type (circle one)**

Electric  Diesel \_\_\_\_\_ Gasoline \_\_\_\_\_ Natural Gas \_\_\_\_\_ Tractor PTO \_\_\_\_\_ Windmill \_\_\_\_\_ Other (describe): \_\_\_\_\_

Horse Power Rating of Motor: 30 Setting Depth: 60 feet Number of Stages: 1

**Pump Test Data for Non Flowing Well**

Date Well Tested: \_\_\_\_\_ Duration of Pump Test (minimum 4 hours): \_\_\_\_\_ hours

Static Water Level (A): 26 Feet Below Land Surface Pumping Water Level (B): \_\_\_\_\_ Feet Below Land Surface

Drawdown [(B) - (A)]: \_\_\_\_\_ Feet Below Land Surface Test Pumping Rate: \_\_\_\_\_ Gallons Per Minute

Method of measurement (circle one): Steel tape \_\_\_\_\_ Electric tape \_\_\_\_\_ Air line \_\_\_\_\_ Other (describe): \_\_\_\_\_

**Pump Test Data for Flowing Well**

Measured shut in head: \_\_\_\_\_ feet.

Well yielded \_\_\_\_\_ GPM with a drawdown of \_\_\_\_\_ feet after \_\_\_\_\_ hours of pumping

**Meter Installation**

Meter Manufacturer: \_\_\_\_\_ Meter Serial Number: \_\_\_\_\_

Meter Model Number/Name: \_\_\_\_\_ Type of Meter: \_\_\_\_\_

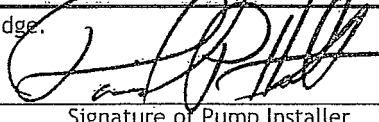
Totalizer Register Unit and Multiplier Factor (AF x .001, gal x 1000, etc): \_\_\_\_\_

Installation Date: \_\_\_\_\_ Meter installed by: \_\_\_\_\_

Is This Meter (circle one): New \_\_\_\_\_ Repaired \_\_\_\_\_ Replacement \_\_\_\_\_

**Important:** By submitting the above information you are certifying that this meter was installed to manufacturer standards. For agricultural wells, a list of approved meters is on the MDEQ website.

I HEREBY CERTIFY that the above statements are true to the best of my knowledge.

DAVID P. HOLT 0-752P 8-22-17   
 Print Name of Pump Installer and License No. (if applicable) Date Signature of Pump Installer

17-0031