


BOLIVAR MISSISSIPPI BOARD OF WATER COMMISSIONERS

J ¹²
3-2-62 **CODED** WATER WELL DRILLERS LOG **CODED** 1253

Date: March 2, 1962, Driller: Layne-Central Company County Bolivar

(Name)

(1) Owner of Land: <u>Merigold Hunting Club</u> (Name)	Description & Color of Materials Sand, Clay, Red Clay, Shell, etc.	Thick- ness Feet	Depth Feet
<u>Merigold, Mississippi</u> (Address)	Clay	22	22
	Fine sand	27	49
(2) Location: <u>1/4, 1/4, Sec. 21 T22N R5W</u>	Coarse sand	45	94
<u>Hunting Club on Lake Beulah.</u>	Coarse sand & pea gravel	53	147
<u>miles</u> , of <u>T22N</u>	Clay	24	171
(distance) (direction) (Nearest Town)	Sandy clay & cement sand	13	184
(3) Topography: <u>flat</u>	Sandy shale	56	240
(Hilly) (Flat) (Level)	Clay	58	298
(4) Purpose of Well: <u>domestic</u>	Clay & sand strks.	21	319
(Domestic Irrigation Municipal, Industrial, Other)	Clay	34	353
Information upon completion of well:	Sand	16	369
(1) Diameter <u>3x3</u> inches.	Clay & sandy clay	106	475
(2) Total Depth <u>576'-5"</u> feet.	Clay & fine sand strks.	66	541
(3) Water Level <u>30</u> feet below top of ground.	Sand	35	576
(4) Cased to <u>542'-11"</u> , Size <u>3"</u>	CODED		
(5) Screen: Size <u>30'-2"</u> , Length <u>3"</u>			
<u>3'-4"</u> B.P.V.			
(6) Were any formations sealed against pollution?			
<u>yes</u> yes, <u>no</u> no.			
If YES depth of formation <u>Packer</u> above the			
screen. Cemented top.			
Why <u>To eliminate all other</u>			
formations.			
Drillers Remarks:			

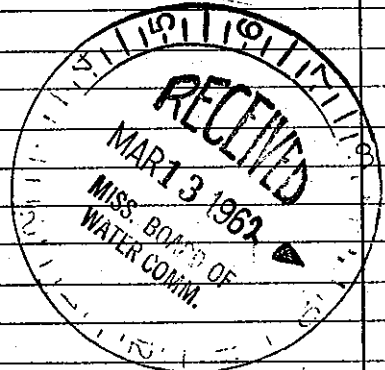

(Use Back Side)

Well No.

Mail this copy to Board of Water Commissioners 429 Miss. St. Jackson, Miss