


Belivar  
J 26  
3-18-67

MISSISSIPPI  
 BOARD OF WATER COMMISSIONERS  
 416 North State Street  
 Jackson, Mississippi 39201

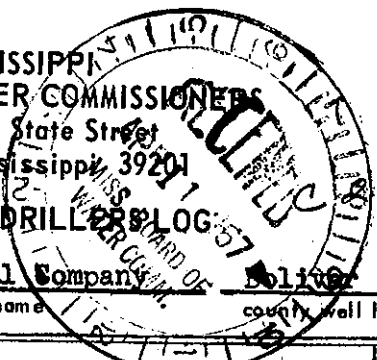

WATER WELL DRILLER'S LOG

March 18, 1967 Layne-Central Company Belivar  
 date well completed firm name county well located

LANDOWNER: H. M. Chenault

description of formations encountered	from	to
Clay	0	12
Medium sand	12	32
Coarse sand	32	45
Coarse sand, pea gravel	45	92
Gravel	92	102

Beulah, Mississippi  
 (mailing address)

WELL LOCATION:

sec. 18 T 22 N R 8 E  
 5 miles SE of Beulah  
 (distance) (direction) (nearest town)

WELL PURPOSE: irrigation  
 (home, irrigation, municipal, industrial)

WELL COMPLETION DATA:

- (1) diameter (inches) 10
- (2) total depth (feet) 102
- (3) static water level (feet) 17' 2" ~~22' 2"~~ above top of ground.
- (4) casing steel 72' (material) (depth)  
 10" (size) If telescope see back.
- (5) screen 30' 102' (length) (depth to top)  
 10" (size) Armco (material)
- (6) pump 15 BPH 1000 (HP) (yield gpm)  
 farm tractor (type power)
- (7) electric log no (yes or no)  
 (organization running log)
- (8) how well bottom plugged plate

DRILLERS REMARKS: