	State VI	all Deport				
2	State Well Report		For Office Use Only:			
County: DOLIVAR	Part 1 Mississippi Department of Environmental Quality		Aquifer:			
Permit #: 6W-39824	Office of Land and Water Resources		Well #: J= 139 of1			
Driller: SIDNLY Cook	P.O. Box 10631					
	-	IS 39289-0631	L. S. Elevation:			
Date drilling completed: 9/24/04		961-5210 4-6938 (fax)	E-log #:			
	(601)354-6938 (fax) E-log #:					
State Law requires that this report be prepared by the driller in detail and filed with the Department within						
30 days of completion of drilling of the well. Well Owner Information		Wel	Location	7		
Owner Name SouthELLO F	— 19и м с	Latitude: 33 • 42 · 30	_" Longitude: <u>91 ° 1 ' 0 "</u>			
Mailing Address: 313 Ruman - SATTERFIELD Ro		Method of Lat/Long (circle or	· · · · ·			
			GPS, Survey-grade GPS			
			Twn 22N Rng SW			
Benort MS City Sta	3872S	IR 74 Sec 1	Iwn ZAN Kng OW			
City Sta	te Zip Code	Distance Direction	Nearest Town of BEULAH MS			
Telephone No. ()		<u> </u>	of BEULAH /VIS			
Well Data						
Purpose of Well (circle one) Home Ind	ustrial Public Supply	heigation Fish Culture	Other:RECI	tiven		
Purpose of Well (circle one) Home Industrial Public Supply Insignation Fish Culture Other: RECEIVED Date well drilling started: $\frac{q}{24} \frac{1}{04}$ Date well drilling completed: $\frac{q}{24} \frac{1}{04}$ OCT 0 2004						
If flowing, method of flow regulation: Valve Other (describe)						
Static Water Level: <u>28</u> feet above or below (circle one) land surface Date measured: $\frac{9}{24}$ BY: OLWR						
Method of Measurement (circle one) steel tape electric tape air line other:						
Hole depth: 10 Well depth: 10 Well grouted to a depth of <u>0</u> feet						
Type of grout (circle one): Cement Bentonite Mix						
Casing length: 70 feet Casing diameter. 16 inches Type of casing: PVC						
Screen length: 40 feet Screen diameter: 16 inches Type of screen: Prc						
Screen slot size: . 032 inches Setting depth: From 270 feet to 70 flo feet						
Type of completion (circle all applicable): Gravel packed Underreamed Telescoped Open hole Natural Development						
	Other (describe):		······			
Top of lap pipe or reduction in casing:feet. If telescoped or more than one screen, describe on back of page						
Logs run (circle all applicable): No log run Electric Gamma Ray Density Sonic Neutron Other:						
Name of organization running log(s):						
I certify that the well was drilled, constructed, and completed in accordance with all applicable requirements of the Mississippi						
Department of Environmental Quality and/or the Mississippi Department of Health regulations and state laws.						
SIDNEY COOK DRILLING # 0-289 SIDNER OON						
Print Name of Water Well Contractor and License No. Signature of Water Well Contractor						

•

÷


011 1-139

If well telescopes please sketch below and show depths.

Ground Level

Description of Formations Encountered	From	То
Clav	0	56
Course Sand & Gravel	56	110
	1	
	•	

If more than one screen, show location of each on sketch

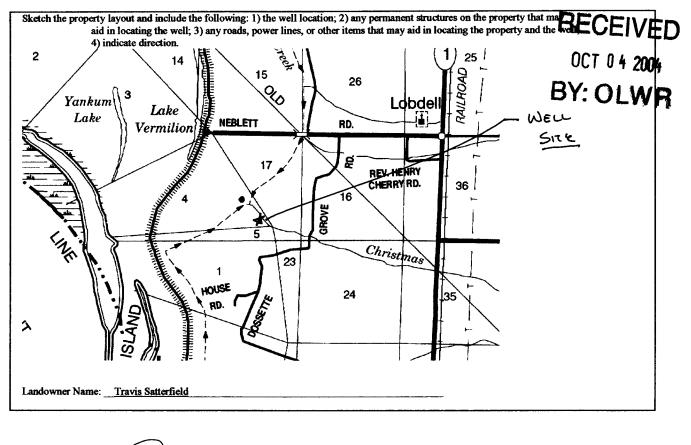

Signature of Water Well Contractor

STATE WELL REPORT

4 • ¹

`

ť

.

County: \bigcirc \bigcirc \bigcirc \bigcirc \bigcirc \bigcirc \bigcirc \bigcirc \bigcirc Pum p Installer'sPermit #: \bigcirc \bigcirc \bigcirc \bigcirc Driller: \bigcirc \bigcirc \bigcirc \bigcirc \bigcirc Driller: \bigcirc \bigcirc \bigcirc \bigcirc Date completed: $9/29/04$ \bigcirc \bigcirc This report should be prepared by the pump installer in detail	For Office Use Only: and Water Resources Box 10631 MS 39289-0631 961-5210 i4-6938 (fax) ail and filed with the Department within 30 days of the		
installation of pump. Well Owner Information	Well Location		
Owner Name: SACEENFIELD FARMS	Latitude: 33 42 30" Longitude: 9 1		
Mailing Address: 313 PALMEN- SATTEREILED RO	Method of Lat/Long (circle one): Conventional Survey,		
	USGS quad, Hand-held GPS, Survey-grade GPS		
Benoiz Ms 38725 City (State Zip Code	SE 1/4 SE 1/4 Sec 4 Twn 22N Rng 8W		
	Distance Direction Nearest Town <u>A</u> Miles <u>SSW</u> of <u>BEULAH</u> REEEIVEE		
Telephone No. ()			
Pump Type Circle one	Power Type OCT 0 4 2004 Circle one		
Air Lift Jet Submersible	Biesel Engine Gasoline Engine BY: OLWR		
Bucket Piston Jurbine	Electric Motor Hand Tractor PTO		
Centrifugal Rotary Flowing Well	Windmill Other (specify):		
Other (specify):	Horse Power Rating of Motor: 60		
Date Pump Installed:	Setting Depth:70feet		
Rated Pump Capacity:Gallons Per Minute	Number of Stages:		
Pump Test Data	Method of Measuring Water Level Circle one		
Date Well Tested:			
Static Water Level (A):Feet Below Land Surface	Air Line Electric Measuring Line Steel Tape Other (specify):		
Pumping Water Level (B):Feet Below Land Surface			
Drawdown [(B) – (A)]:Feet Below Land Surface	For flowing well, measured shut in head:feet		
Test Pumping Rate:Gallons Per Minute	Well yielded GPM with a drawdown of		
Duration of Pump Test (minimum 4 hours):hours	feet afterhours of pumping		

I HEREBY CERTIFY that the above statements are true to the best of	my knowledge.
Print Name of Pump Installer and License No. (if applicable)	MATT STEPHENS Matt Stephens Signature of Pump Installer