

BOLIVAR MISSISSIPPI BOARD OF WATER COMMISSIONERS

J 2000
10-27-62

WATER WELL DRILLERS LOG


Bolivar

Date: 10/27, 1962, Driller: Bailey Drilling Co. County: Washington
(Name)

| (1) Owner of Land: | Description & Color of Materials Sand, Clay, Red Clay, Shell, etc. | Thick- ness Feet | Depth Feet |
|--|---|------------------------|---------------|
| Charles Wilson (Name) Benoit Miss (Address) | Clay | | 20 |
| | Sand | | 100 |
| | Mud | | 205 |
| (2) Location: 1/4, 1/4, Sec. T R | Mud + Sand | | 225 |
| 5 miles North of Benoit (distance) (direction) (Nearest Town) | Mud | | 307 |
| | Mud + Sand | | 369 |
| (3) Topography: Flat (Hilly) (Flat) (Level) | Mud | | 430 |
| | Mud + Sand | | 450 |
| (4) Purpose of Well: Domestic (Domestic Irrigation Municipal, Industrial, Other) | Sand | | 485 |

Information upon completion of well:

- (1) Diameter: 3x2 inches.
- (2) Total Depth: 485 feet.
- (3) Water Level: 22 feet below top of ground.
- (4) Cased to: all way. Size: 3x2.
- (5) Screen: Size: 2, Length: 10ft.
- (6) Were any formations sealed against pollution?
yes, no.

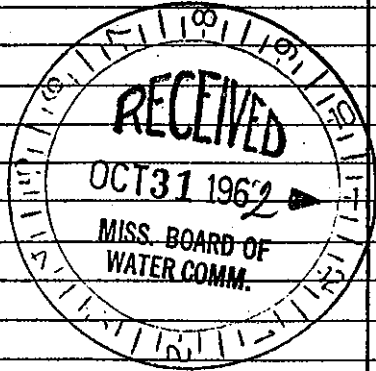

If YES depth of formation: _____
Why: _____
Drillers Remarks: _____

Well No.

(Use Back Side)