

BOLIVAR MISSISSIPPI BOARD OF WATER COMMISSIONERS

OK-32

8-23-57 WATER WELL DRILLERS LOG

9/17/65
Jm
C386

Date: August 23, 1957, Driller: Layne-Central Company of Bolivar
(Name)

CODED

(1) Owner of Land: <u>W. R. Wilson</u> (Name)	Description & Color of Materials Sand, Clay, Red Clay, Shell, etc.	Thick- ness Feet	Depth Feet
<u>Rosedale, Mississippi</u> (Address)	Top sandy soil	17	17
(2) Location: <u>1/4, 1/4, Sec. 5 T22R7</u>	Coarse sand	15	32
<u>2 miles east</u> of <u>Beulah</u> (distance) (direction) (Nearest Town)	Sand	10	42
(3) Topography: <u>flat</u> (Hilly) (Flat) (Level)	Sand & pea rock	20	62
(4) Purpose of Well: <u>irrigation</u> (Domestic Irrigation Municipal, Industrial, Other)	Coarse sand & clay balls	10	72
	Pea rock & sand	10	82
	Sand & pea rock	10	92
	Sand & big gravel	20	112
	Sand & gravel	10	122

Information upon completion of well:

(1) Diameter 12 inches.

(2) Total Depth 122 feet.

(3) Water Level 14'7" feet below top of ground.

(4) Cased to 72', Size 12".

(5) Screen: Size 12", Length 50'.


(6) Were any formations sealed against pollution?
 yes, no.

If YES depth of formation _____

Why _____

Drillers Remarks: _____
1669 GPM.
Engine Drive.

CODED

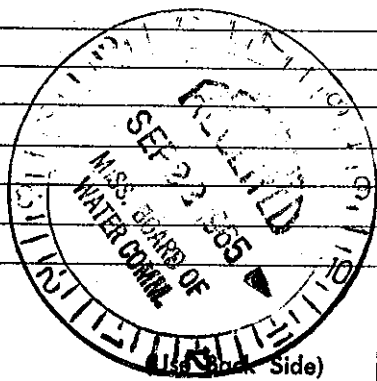

Well No.

Mail this copy to Board of Water Commissioners 429 Miss. St. Jackson, Miss