

BOLIVAR MISSISSIPPI BOARD OF WATER COMMISSIONERS

JK-34
5-5-61

WATER WELL DRILLERS CODED

CODED

Date: May 5, 1961, Driller: Layne-Central Company County Bolivar
(Name)

(1) Owner of Land: Dixon Dossett
(Name)
Beulah, Mississippi
(Address)

(2) Location: 1/4, 1/4, Sec. 19 T22R7,
4 miles south, of Beulah
(distance) (direction) (Nearest Town)


(3) Topography: flat
(Hilly) (Flat) (Level)

(4) Purpose of Well: irrigation
(Domestic Irrigation, Municipal, Industrial, Other)

Description & Color of Materials Sand, Clay, Red Clay, Shell, etc.	Thick- ness Feet	Depth Feet
Clay	25	25
Fine sand	10	35
Coarse sand	10	45
Streaks of fine sand	10	55
Coarse sand & pea gravel	20	75
Coarse sand and gravel	37	112

CODED

CODED

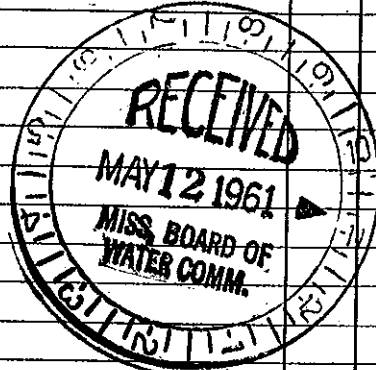

Information upon completion of well:

(1) Diameter 16 inches.

(2) Total Depth 112 feet.

(3) Water Level 7 feet below top of ground.

(4) Cased to 62', Size 16"

(5) Screen: Size 16", Length 50'

(6) Were any formations sealed against pollution?
no yes, X no.

If YES depth of formation _____

Why _____

Drillers Remarks: _____

Well No. _____

(Use Back Side)

Mail this copy to Board of Water Commissioners 429 Miss. St. Jackson, Miss.