

BOLIVAR MISSISSIPPI BOARD OF WATER COMMISSIONERS *Coded*

K 36

CODED 300

5-27-60 WATER WELL DRILLERS LOG

Date: May 27, 1960, Driller: Layne-Central Company County Bolivar
(Name)

(1) Owner of Land: <u>F. B. Aylward</u> (Name)	Description & Color of Materials Sand, Clay, Red Clay, Shell, etc.	Thick- ness Feet	Depth Feet
<u>Pace, Mississippi</u>	<u>Clay</u>	<u>19</u>	<u>19</u>
<u>southwest of Pace, Miss.</u> (Address)	<u>Fine sand</u>	<u>11</u>	<u>30</u>
(2) Location: <u>11 T 22 R 7 W</u> <u>southwest of</u>	<u>Coarse sand</u>	<u>45</u>	<u>75</u>
<u>11 T 22 R 7 W</u> <u>southwest of</u>	<u>Coarse sand & pea gravel</u>	<u>87</u>	<u>162</u>
<u>11 T 22 R 7 W</u> <u>southwest of</u>	<u>Blue clay</u>	<u>31</u>	<u>193</u>
<u>11 T 22 R 7 W</u> <u>southwest of</u>	<u>Shale & Strks. of fine sand</u>	<u>62</u>	<u>255</u>
<u>11 T 22 R 7 W</u> <u>southwest of</u>	<u>Fine sand & shale</u>	<u>45</u>	<u>300</u>
<u>11 T 22 R 7 W</u> <u>southwest of</u>	<u>Fine sand</u>	<u>60</u>	<u>360</u>
<u>11 T 22 R 7 W</u> <u>southwest of</u>	<u>Sand</u>	<u>70</u>	<u>430</u>
<u>11 T 22 R 7 W</u> <u>southwest of</u>	<u>Clay</u>	<u>7</u>	<u>437</u>

(3) Topography: level
(Hilly) (Flat) (Level)

(4) Purpose of Well: domestic
(Domestic Irrigation, Municipal, Industrial, Other)

Information upon completion of well:

(1) Diameter 4x3 inches.

(2) Total Depth 437 feet.

(3) Water Level 15' feet below top of ground.

(4) Cased to 417', Size 4x3


(5) Screen: Size 3", Length 20'

(6) Were any formations sealed against pollution?
 yes, no.

If YES depth of formation packer above screen

Why to eliminate all other formations.

Drillers Remarks:

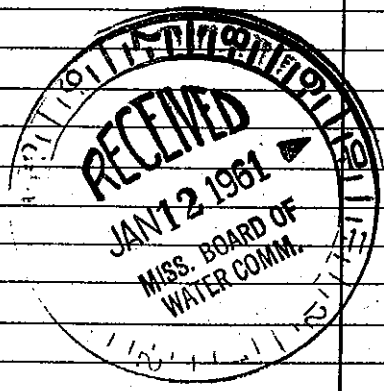

(Use Back Side)

Well No.

Mail this copy to Board of Water Commissioners 429 Miss. St. Jackson, Miss.