

BOLIVAR MISSISSIPPI BOARD OF WATER COMMISSIONERS *Coded*

WATER WELL DRILLERS LOG

CO-CODED K 302

3-20-61

Date: *3/20*, 19*61*, Driller: *Delta Wells Supply* County *Bolivar*.

(Name)

(1) Owner of Land: <i>E. N. Mc Knight</i> (Name)	Description & Color of Materials Sand, Clay, Red Clay, Shell, etc.	Thick- ness Feet	Depth Feet
<i>Cleveland, Miss.</i> (Address)	<i>Top soil & clay</i>	<i>17</i>	<i>17</i>
(2) Location: $\frac{1}{4}$, $\frac{1}{4}$, Sec. <i>17</i> T <i>22R7W</i>	<i>Fine sand</i>	<i>12</i>	<i>29</i>
<i>3</i> miles <i>SE</i> of <i>Pace</i> (distance) (direction) (Nearest Town)	<i>Fine sand & clay</i>	<i>10</i>	<i>39</i>
(3) Topography: <i>Flat</i> (Hilly) (Flat) (Level)	<i>" " to road.</i>	<i>30</i>	<i>69</i>
(4) Purpose of Well: <i>Irrigation</i> (Domestic Irrigation Municipal, Industrial, Other)	<i>course "</i>	<i>11</i>	<i>80</i>
	<i>" " & gravel</i>	<i>44</i>	<i>124.4</i>

CODED
CODED


Information upon completion of well:

- (1) Diameter *16* inches.
- (2) Total Depth *124 4* feet.
- (3) Water Level *16 ft.* feet below top of ground.
- (4) Cased to _____, Size _____
- (5) Screen: Size *16*, Length *40 ft.*
- (6) Were any formations sealed against pollution?
_____ yes, no.

If YES depth of formation _____

Why _____

Drillers Remarks: _____

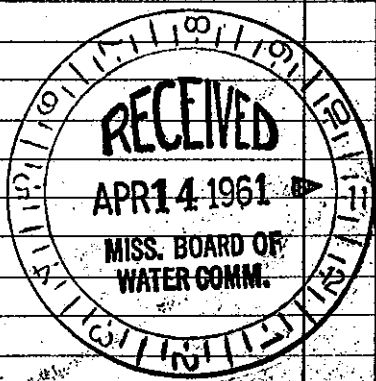

(Use Back Side)

Well No.

Mail this copy to Board of Water Commissioners 429 Miss. St. Jackson, Miss