


**BOLIVAR MISSISSIPPI BOARD OF WATER COMMISSIONERS**  
**K** **49** **CODED**  
**2-24-64** **CODED**  
**WATER WELL DRILLERS LOG 3/4/64**  
 Date: Feb. 24,, 19 64, Driller: Layne-Central Company County Bolivar  
 (Name) 1740 R

	Description & Color of Materials Sand, Clay, Red Clay, Shell, etc.	Thick- ness Feet	Depth Feet
(1) Owner of Land: <u>Dominic P. Rizzo</u> (Name) <u>Cleveland, Mississippi</u> (Address)	Clay	12	12
(2) Location: <u>1/4,</u> <u>1/4,</u> Sec <u>36</u> T. <u>R7W</u> , <u>3</u> miles <u>southwest</u> , of <u>Face</u> (distance) (direction) (Nearest Town)	Fine sand	23	35
(3) Topography: <u>flat</u> (Hilly) (Flat) (Level)	Coarse sand	10	45
(4) Purpose of Well: <u>irrigation</u> (Domestic Irrigation Municipal, Industrial, Other)	Coarse sand, pea gravel	30	75
Information upon completion of well: (1) Diameter <u>18</u> inches. (2) Total Depth <u>112</u> feet. (3) Water Level <u>17'-3"</u> feet below top of ground. (4) Cased to <u>62'</u> , Size <u>18"</u> <u>slotted pipe</u> (5) Screen: Size <u>18"</u> , Length <u>50'</u> (6) Were any formations sealed against pollution? <u>      </u> yes, <u>  no  </u> no. If YES depth of formation _____ Why _____ Drillers Remarks: _____   _____  _____ _____	Coarse sand, gravel	37	112

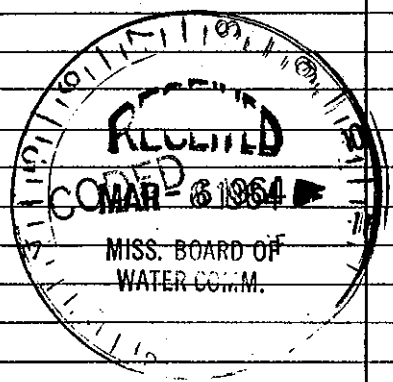

(Use Back Side)

Well No.

Mail this copy to Board of Water Commissioners 429 Miss. St. Jackson, Miss.