

CODED

MISSISSIPPI  
BOARD OF WATER COMMISSIONERS  
416 North State Street  
Jackson, Mississippi 39201

4/29/68  
CODED 2625

BOLIVAR  
K 53  
3-68

WATER WELL DRILLERS LOG

March 28, 1968 Layne-Central Company Bolivar  
date well completed firm name county well located

LANDOWNER: Dossett Plantations inc.	Description of formations encountered	from	to
	Clay	0	12
	Fine sand	12	28
Beulah, Mississippi (mailing address)	Gray sand, few pea gravel	28	42
WELL LOCATION: SW 1/4 NW 1/4 sec. 21 T. 22 N. R. 7 E	Coarse sand and gravel	42	111

CODED


3-1/2 miles south of Beulah (distance) (direction) (nearest town)

WELL PURPOSE: irrigation (home, irrigation, municipal, industrial)

CODED

WELL COMPLETION DATA:

- (1) diameter (inches) 16
- (2) total depth (feet) 111
- (3) static water level (feet) 13' 6" above top of ground.
- (4) casing steel, 62' (material) (depth)  
16" (size) If telescope see back.
- (5) screen 50' (length), 111' (depth to top)  
16" (size) Armco (material)
- (6) pump 40 (HP) 2200 (yield gpm)  
electric (type power)
- (7) electric log no (yes or no)  
(organization running log)
- (8) how well bottom plugged plate

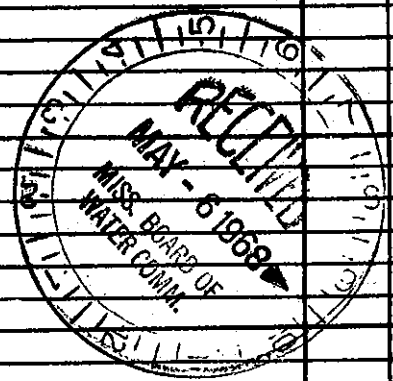

DRILLERS REMARKS: