

Bolivar
K 63
3-17-81
CL-1610
3-17-

MISSISSIPPI DEPARTMENT OF NATURAL RESOURCES

Bureau of Land and Water Resources

Southport Mall

P.O. Box 10631

Jackson, Mississippi 39209


WATER WELL DRILLERS LOG CODED

3-17-81 81 Layne-Central Company Bolivar  
 date well completed firm name county well located

LANDOWNER:	description of formations encountered	from	to
Dahomey Plantation		0	26
Benoit, MS (mailing address)	Sandy Clay	26	36
	Coarse sand	36	50
WELL LOCATION: 29 22 sec. T N R 7 5 miles NE of Benoit (distance) (direction) (nearest town)	sand Med Coarse	50	64
	Coarse sand	64	78
	Coarse sand & gr.	78	81
	Clay	81	90
	Coarse sand & gr.	90	119
	Clay	119	120

WELL PURPOSE: irrigation  
 (home, irrigation, municipal, industrial)

- WELL COMPLETION DATA:
- (1) diameter (inches) 32"
  - (2) total depth (feet) 120'
  - (3) static water level (feet) 21" <sup>below</sup> top of ground
  - (4) casing steel 61' (material), (depth)  
 16" (size) if telescope see back.
  - (5) screen 59' (length), 61' (depth to top)  
 16" (size), Doerr (material)
  - (6) pump 60 (HP), 2500 (yield gpm)  
 Diesel (type power)
  - (7) electric log no (yes or no)  
 none (organization running log)
  - (8) how well bottom plugged steel plated

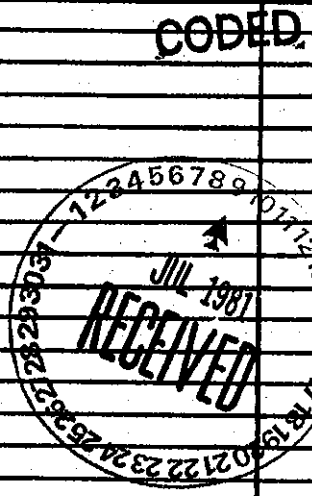

DRILLERS REMARKS: