

Dahoney #6  
corner of Tree's way  
**State Well Report**

Part I

Mississippi Department of Environmental Quality  
Office of Land and Water Resources  
P.O. Box 10631  
Jackson, MS 39289-0631  
(601)961-5210  
(601)354-6938 (fax)

County: BOLIVAR  
 Permit #: 00043217 ✓  
 Driller: J. NEWCOME 0-773  
 Date drilling completed: 4-28-09

For Office Use Only:

Aquifer: \_\_\_\_\_  
 Well #: K-110  
 L. S. Elevation: \_\_\_\_\_  
 E-log #: \_\_\_\_\_

State Law requires that this report be prepared by the driller in detail and filed with the Department within 30 days of completion of drilling of the well.

Well Owner Information	Well Location
Owner Name: <u>Dahoney Plantation</u>	Latitude: <u>33.42.32</u> Longitude: <u>90.57.17</u>
Mailing Address: <u>114 Hickory Creek Circle</u>	Method of Lat/Long (circle one): Conventional Survey
<u>Little Rock, AL 37212</u>	USGS quad: <u>Hand-held GPS</u> Survey-grade GPS
City: _____ State: _____ Zip Code: _____	<u>NE</u> 1/4 <u>SW</u> 1/4 Sec <u>32</u> Twn <u>22N</u> Rng <u>TW</u>
Telephone No. <u>(501) 993-0800</u>	Distance: <u>4</u> Miles Direction: <u>NE</u> of Nearest Town: <u>BENIT</u>

**Well Data**

Purpose of Well (circle one) Home Industrial Public Supply Irrigation Fish Culture Other: \_\_\_\_\_

Date well drilling started: 4-28-09 Date well drilling completed: 4-28-09

If flowing, method of flow regulation: Valve \_\_\_\_\_ Other (describe) \_\_\_\_\_

Static Water Level: \_\_\_\_\_ feet above or below (circle one) land surface Date measured: \_\_\_\_\_

Method of Measurement (circle one) steel tape electric tape air line other: \_\_\_\_\_

Hole depth: 123 Well depth: 120 Well grouted to a depth of 10 feet

Type of grout (circle one): Cement Bentonite Mix

Casing length: 80 feet Casing diameter: 16 inches Type of casing: PVC

Screen length: 40 feet Screen diameter: 16 inches Type of screen: PVC

Screen slot size: .050 inches Setting depth: From 80 feet to 120 feet

Type of completion (circle all applicable): Gravel packed Underreamed Telescoped Open hole Natural Development

Other (describe): \_\_\_\_\_

Top of lap pipe or reduction in casing: \_\_\_\_\_ feet. If telescoped or more than one screen, describe on back of page

Logs run (circle all applicable) No log run Electric Gamma Ray Density Sonic Neutron Other: \_\_\_\_\_

Name of organization running log(s): \_\_\_\_\_


**I certify that the well was drilled, constructed, and completed in accordance with all applicable requirements of the Mississippi Department of Environmental Quality and/or the Mississippi Department of Health regulations and state laws.**

JOHN NEWCOME 0-773 \_\_\_\_\_  
 Print Name of Water Well Contractor and License No. Signature of Water Well Contractor

**RECEIVED**  
 JUN 01 2009  
 BY: OLWR

If well telescopes please sketch below and show depths.


Ground Level

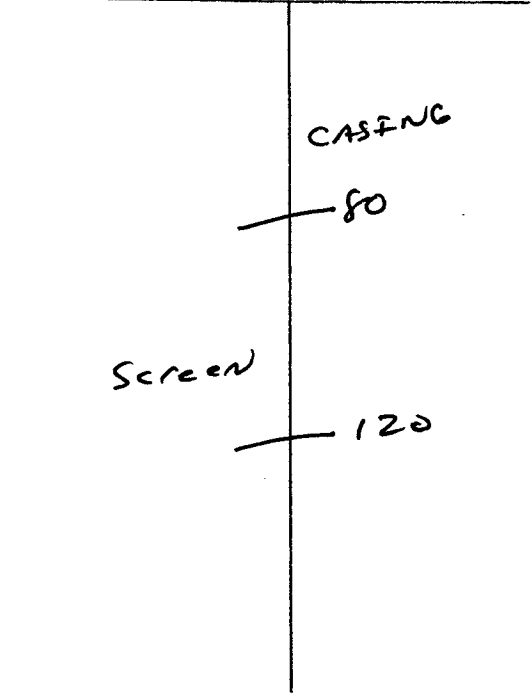

Description of Formations Encountered	From	To
TOP Soil	0	10
Mix CLAY	10	28
Med. Fine Sand	28	80
COARSE SAND	80	118
Fine Sand	118	123

If more than one screen, show location of each on sketch

Sketch the property layout and include the following: 1) the well location; 2) any permanent structures on the property that may aid in locating the well; 3) any roads, power lines, or other items that may aid in locating the property and the well; 4) indicate direction.

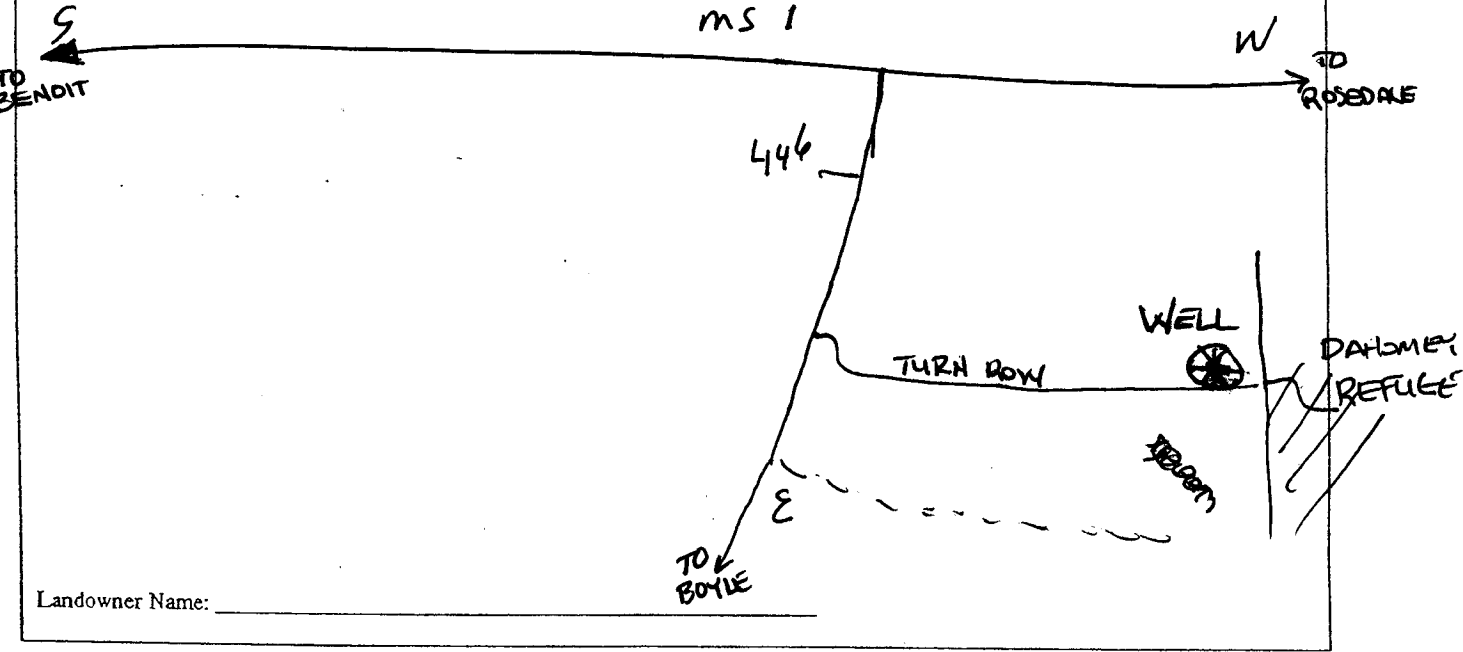

Landowner Name: \_\_\_\_\_

John Newman  
Signature of Water Well Contractor

# STATE WELL REPORT

## Part 2

**Pump Installer's Completion Report**  
 Mississippi Department of Environmental Quality  
 Office of Land and Water Resources  
 P.O. Box 10631  
 Jackson, MS 39289-0631  
 (601)961-5210  
 (601)354-6938 (fax)

For Office Use Only:

Aquifer: \_\_\_\_\_  
 Well #: K-110  
 Elevation: \_\_\_\_\_

County: Bolivar  
 Permit #: 6W 43217  
 Driller: J. Newcome  
 Date completed: 4-28-09

This report should be prepared by the pump installer in detail and filed with the Department within 30 days of the installation of pump.

Well Owner Information	Well Location
Owner Name: <u>Dahomey Plantation</u>	Latitude: <u>33° 42' 32" N</u> Longitude: <u>90° 57' 17" W</u>
Mailing Address: <u>1/2 Jimmy Winemiller</u> <u>114 Hickory Creek Crude</u> <u>Little Rock, AR 72212</u>	Method of Lat/Long (circle one): Conventional Survey, USGS quad, Hand-held GPS, Survey-grade GPS
City: _____ State: _____ Zip Code: _____	<u>NE</u> 1/4 <u>SW</u> 1/4 Sec <u>32</u> Twn <u>22N</u> Rng <u>7W</u>
Telephone No. <u>(501) 993-0800</u>	Distance: <u>4</u> Miles Direction: <u>NE</u> of Nearest Town: <u>Benoit</u>

Pump Type Circle one	Power Type Circle one
Air Lift      Jet      Submersible	<u>Diesel Engine</u> Gasoline Engine      Natural Gas
Bucket      Piston <u>Turbine</u>	Electric Motor      Hand      Tractor PTO
Centrifugal      Rotary      Flowing Well	Windmill      Other (specify): _____
Other (specify): _____	Horse Power Rating of Motor: <u>60</u>
Date Pump Installed: <u>4/29/09</u>	Setting Depth: <u>70</u> feet
Rated Pump Capacity: <u>2800</u> Gallons Per Minute	Number of Stages: <u>1</u>

Pump Test Data	Method of Measuring Water Level Circle one
Date Well Tested: _____	Air Line      Electric Measuring Line      Steel Tape
Static Water Level (A): _____ Feet Below Land Surface	Other (specify): _____
<u>NOT</u> Pumping Water Level (B): _____ Feet Below Land Surface	For flowing well, measured shut in head: _____ feet
Drawdown [(B) - (A)]: _____ Feet Below Land Surface	Well yielded _____ GPM with a drawdown of _____ feet after _____ hours of pumping
Test Pumping Rate: _____ Gallons Per Minute	
Duration of Pump Test (minimum 4 hours): _____ hours	

I HEREBY CERTIFY that the above statements are true to the best of my knowledge.

Comp Rowe 0-711P  
 Print Name of Pump Installer and License No. (if applicable)

[Signature]  
 Signature of Pump Installer

RECEIVED

JUN 0 1 2009

BY: OLWR