

State Well Report

Part 1 - Driller's Log

Mississippi Department of Environmental Quality
 Office of Land and Water Resources
 P.O. Box 2307
 Jackson, MS 39225
 (601)961- 5210
 (601)961- 5228 (fax)

County Bolivar
 Permit # GW-44396
 Driller: Clarence McMurtry
 Date drilling completed 6-26-10

For Office Use Only:
 Aquifer K 115
 Well # _____
 I. S. Elevation _____
 E-log #: _____

State Law requires that this report be prepared by the license holder responsible for the work and filed with the Department at the above address within 30 days of completion of drilling of the well or borehole.

<p>Information on Well Owner (Landowner if borehole is not for a water well)</p> <p>Owner Name: <u>Brig Aylward Farms</u> Mailing Address: <u>P.O. Box 251</u> <u>Pace</u> MS 38764 City State Zip Code Telephone No. <u>(662) 719-6268</u></p>	<p>Well or Borehole Location</p> <p>Latitude: <u>N33° 46' 05.4"</u> Longitude: <u>W90° 52' 18.72"</u> <u>00</u> <u>19</u> Method of Lat/Long (circle one): Conventional Survey, USGS quad, <u>Hand-held GPS</u> Survey-grade GPS <input checked="" type="checkbox"/> <u>48</u> <u>SE</u> <u>12</u> <u>22N</u> <u>7W</u> NE 1/4 Sec 12 Twn 22N Rng 7W Distance Direction Nearest Town <u>2</u> Miles <u>South</u> of <u>Pace</u></p>
--	---

Well / Borehole Data

Date drilling started: 6/26/10 Date drilling completed: 6/26/10 Hole depth: 120' Hole diameter: 26"

Location of the source of any surface water used for drilling: Rice field
 Method of dosing and volume of Chlorine used in drilling and development: _____

Logs run (circle all applicable): No log run Electric Gamma Ray Density Sonic Neutron Other: _____
 Name of organization running log(s): _____

Purpose of borehole (check one): Water Well Geotechnical/Geological Investigation _____ Ground Source Heat Pump _____
 Seismic Survey _____ Other (describe) _____

If drilling is not related to water well construction, skip the remainder of this block

Purpose of Well (check one): Home _____ Industrial _____ Public Supply _____ Irrigation _____ Fish Culture _____ Other: _____

If a flowing well, method of flow regulation: Valve _____ Other (describe) N/A

Static Water Level: 42 feet above or below (circle one) land surface Date measured: 6-28-10

Method of Measurement (circle one) steel tape electric tape air line other: _____

Well depth: 120' Well grouted to a depth of 10 feet Type of grout (circle one): Neat Cement Bentonite Mix

Casing length: 70 feet Casing diameter: 16 inches Type of casing: PVC

Screen length: 50 feet Screen diameter: 16 inches Type of screen: PVC

Screen slot size: .030 inches Setting depth. From 70 feet to 120 feet

Type of completion (circle all applicable): Gravel packed Underreamed Telescoped Open hole Natural Development
 Other (describe): _____

Top of lap pipe or reduction in casing: N/A feet. *If telescoped or more than one screen, describe on next page*

Replacement Well


K115

The sketch below only required for water wells

Description of formations encountered must be provided for all wells and boreholes, unless specifically exempted by regulations

If well telescopes, show depths on sketch.


Ground Level →

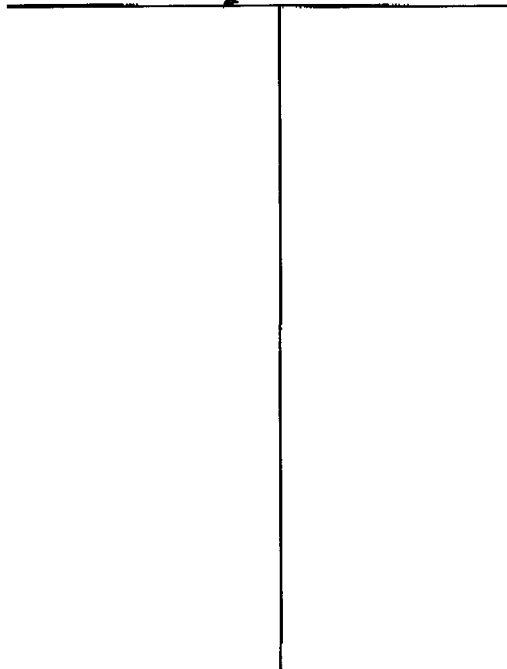

Description of Formations Encountered	From (depth)	To (depth)
CLAY	Ground Level	23
Fine Sand	23	42
Medium & Coarse Sand	42	75
Pca Gravel		75
Medium & Coarse Sand & Gravel	75	117
Medium Sand	117	120

If more than one screen, show location of each on sketch

Sketch the property layout and include the following: 1) the well location; 2) any permanent structures on the property that may aid in locating the well; 3) any roads, power lines, or other items that may aid in locating the property and the well, 4) a north arrow.

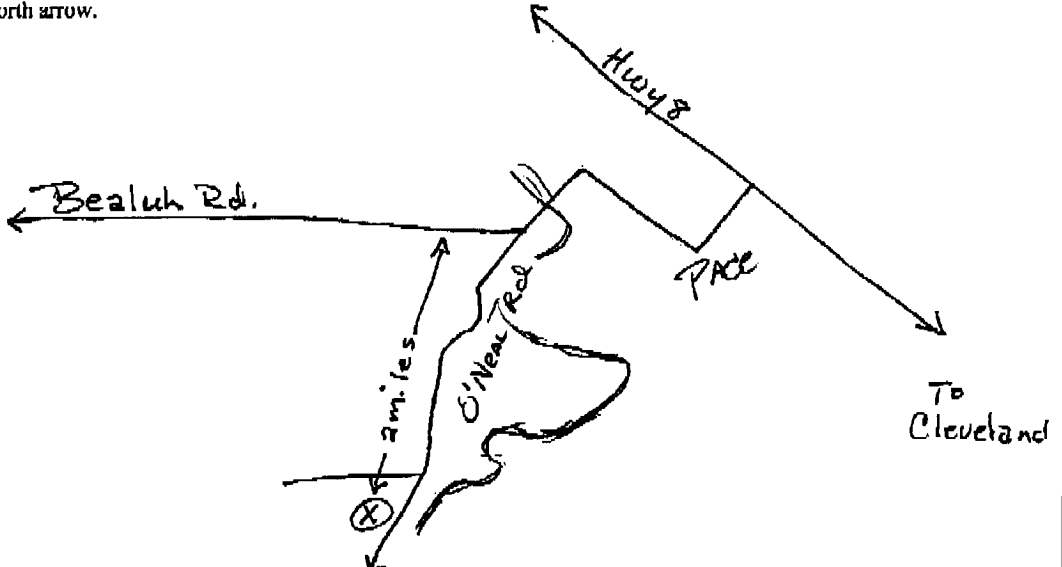

Landowner Name: Brig Aylward Farms

Form: OLWR-SWR-1A (01/08)

I certify that the well/borehole was drilled, constructed, and completed in accordance with all applicable requirements of the Mississippi Department of Environmental Quality and the Mississippi Department of Health regulations, if applicable, and state laws.

Clayton Miller 0-703 6-30-10 Clayton Miller
 Print Name of Responsible Licensee and License No. Date Signature of Licensee

STATE WELL REPORT

13115

County BALIVAR
 Permit # GW-44396
 Driller: John Rybolt IV
 Date completed: 6-28-10
Copy information from block on Part 1

Part 2
Pump Installer's Completion Report
 Mississippi Department of Environmental Quality
 Office of Land and Water Resources
 P.O. Box 2309
 Jackson, MS 39225
 (601)961-5210
 (601)961-5228 (fax)

For Office Use Only:
 Aquifer _____
 Well #: _____
 Elevation: _____

This part of the report must be completed by a licensed water well contractor or a licensed pump installer. A copy of Part 1 of the report must be attached and both parts filed with the Department at the above address within 30 days of well completion.

Well Owner Information	Well Location
Owner Name: <u>Brig Aylward Farms</u>	Latitude: <u>N33°46'0.54"</u> Longitude: <u>W90°52'18.72"</u>
Mailing Address: <u>P.O. Box 251</u>	Method of Lat/Long (check one): Conventional Survey _____, USGS quad _____, Hand-held GPS <input checked="" type="checkbox"/> Survey-grade GPS _____
<u>PAGE</u> <u>MS</u> <u>38764</u> City State Zip Code	____ 1/4 ____ 1/4 Sec <u>12</u> T <u>22N</u> R <u>7W</u>
Telephone No. <u>(662) 719 6268</u>	Distance Direction Nearest Town <u>2</u> Miles <u>South</u> of <u>PAGE</u>

Pump Type Circle one	Power Type Circle one
Air Lift Jet Submersible	Diesel Engine Gasoline Engine Natural Gas
Bucket Piston <u>Turbine</u>	Electric Motor Hand Tractor PTO
Centrifugal Rotary Flowing Well	Windmill Other (specify): <u>Gear Drive</u>
Other (specify): _____	Horse Power Rating of Motor: <u>60</u>
Date Pump Installed: <u>6-28-10</u>	Setting Depth: <u>60</u> feet
Rated Pump Capacity: _____ Gallons Per Minute	Number of Stages: <u>1</u>

Pump Test Data	Method of Measuring Water Level Circle one
Date Well Tested: <u>NOT TESTED</u>	Air Line <u>Electric Measuring Line</u> Steel Tape
Static Water Level (A): <u>42</u> Feet Below Land Surface	Other (specify): _____
Pumping Water Level (R): <u>N/A</u> Feet Below Land Surface	For flowing well, measured shut in head: <u>N/A</u> feet
Drawdown [(B) - (A)]: <u>N/A</u> Feet Below Land Surface	Well yielded <u>N/A</u> GPM with a drawdown of _____ feet after _____ hours of pumping
Test Pumping Rate: <u>N/A</u> Gallons Per Minute	
Duration of Pump Test (minimum 4 hours): <u>N/A</u> hours	

I HEREBY CERTIFY that the above statements are true to the best of my knowledge.

Clayton Miller 0-703
 Print Name of Pump Installer and License No. (if applicable)

Clayton Miller
 Signature of Pump Installer

Form: OLWR-SWR-1B (04/08)

Existing Pump