	State Well F	leport 1		
county: Bolivar	Part 1		For Office Use Only:	
ounty: 1000 val	Mississippi Department of Er	Aquifer:		
Permit # $(0/04/78)$	Office of Land and Wa	ter Resources	Well #: Notan	
TAMES HAGE	P.O. Box 10		KI31	
Date drilling completed: <u>4-17-07</u>	Jackson, MS 39289-0631 (601)961-5210		L.S. Elevation: <u>K131</u>	
Date drilling completed:	(601)354-6938		E-log #:	
State Law requires that this rep	oort be prepared by the drille	r in detail and filed w	ith the Department within	
30 days of completion of drillin Well Owner Inform		Wel	Location	
	1			
Wher Name Dahomey Plant	ation Latit	ude: 33 ° 43 ' 05	" Longitude: <u>90 ° 58 ' 30</u> "	
Mailing Address: Co Jimmy		47 13 od of Lat/Long (circle o	ne): Conventional Survey, 45	
14 Hickory C	· · · · · · · · · · · · · · · · · · ·	USGS guad, (Hand-held	I GPS Survey-grade GPS	
LITTLE ROCK	Ar 72212 1	1/4 SEE 1/4 Sec 20	Twn HA Rng BW	
	tate Zip Code	ance Direction		
Telephone No. 501 - 692 -	<u>4391</u>	<u>0 Miles N</u>	of BENDIT	
	•			
	Well Data			
Purpose of Well (circle one) Home I	ndustrial Public Supply (Irrig	ation Fish Culture	Other:	
Date well drilling started: 4-17-0				
Date well drilling started:	-, Date well d	ming completed.	./	
If flowing, method of flow regulation: V	alve Other (describ	e)		
Static Water Level: 28 feet	above or below (circle one) land s	urface Date measured		
Method of Measurement (circle one)	• •			
Hole depth: 125 Well	depth: W	ell grouted to a depth of	feet	
Type of grout (circle one): Cement				
-			OUC	
Casing length: <u>\$3.5</u> feet C	asing diameter: <u>6</u> inc	hes Type of casing:	PUC	
Screen length: <u>40</u> feet S			-	
Screen slot size:inche	s Setting depth: From	feet to	feet feet	
Type of completion (circle all applicabl	e): Gravel packed Underream	ed Telescoped Ope	en hole Natural Development	
- • • •				
	Other (describe):			
	feet. If telesco	ped or more than one s	creen, describe on back of page	
Top of lap pipe or reduction in casing:				
		mailer Camia Mana	Other	
Top of lap pipe or reduction in casing: Logs run (circle all applicable) No log		nsity Sonic Neutron	Other:	
Logs run (circle all applicable) No log Name of organization running log(s):	run Electric Gamma Ray De	-	· · ·	
Logs run (circle all applicable) No log	run Electric Gamma Ray De	-	· · ·	
Logs run (circle all applicable) No log Name of organization running log(s):	structed, and completed in accord	dance with all applicab	le requirements of the Mississippi	
Logs run (circle all applicable) No log Name of organization running log(s): _ I certify that the well was drilled, con	structed, and completed in accord	dance with all applicab	le requirements of the Mississippi	
Logs run (circle all applicable) No log Name of organization running log(s): _ I certify that the well was drilled, con	structed, and completed in accor ty and/or the Mississippi Departu	dance with all applicab	le requirements of the Mississippi ns and state laws.	


t ·

JUL 1 6 2007 BY: OLWR

K131


If well telescopes please sketch below and show depths.

Ground Level

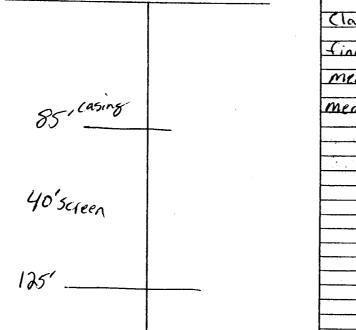

Description of Formations Encountered	From	To
Clay	0	4
fine	4	60
Medium	60	85
medium (oarse	85	125
and the second		
· · · · · · · · · · · · · · · · · · ·		

If more than one screen, show location of each on sketch

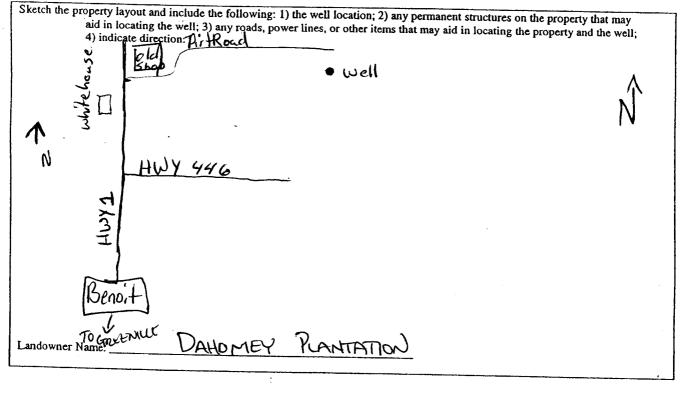

ame Signature of Water Well Contractor

N-

		LL REFURI	
County Balivan Permit # GW 41981	Part 2 Pump Installer's Completion Report Mississippi Department of Environmental Quality Office of Land and Water Resources P.O. Box 10631 Jackson, MS 39289-0631 (601)961-5210 (601)354-6938 (fax)		For Office Use Only: Aquifer:
Driller SAMES HAKCAN Date completed: 4-17-07			Well #: 127 Elevation:
This report should be prepared by the pinstallation of pump.		and filed with the Departmen	at within 30 days of the
Owner Name Abtomer Information Mailing Address: 10 5: mmy W	NTOTON	Latitudo 3-43-05 47-13	67 45
114 Harrow	CREEK LINCL L. 72212 Zip Code	NE VNE 1/4 Sec. 31	Two The Rng Stor
Telephone No (01-692-4-39	2/	Distance Direction	Nearest Town
Pump Type Circle one		,	wer Type ircle one
Air Lift Jet	Submersible (Diesel Engine Gasoli	ne Engine Natural Gas
Bucket Piston	Turbine	Electric Motor Hand	Tractor PTO
Centrifugal Rotary	Flowing Well	Windmill Other	(specify):
Other (specify): Date Pump Installed: 5 - 17-07	· · · · · · · · · · · · · · · · · · ·	Horse Power Rating of Motor Setting Depth:	r:
Rated Pump Capacity: 3000	Gallons Per Minute	Number of Stages:	
Pump Test Data			easuring Water Level Circle one
Date Well Tested: Static Water Level (A):Feet H	elow Land Surface	Air Line Electric Me Other (specify):	asuring Line Steel Tape
Pumping Water Level (B): Feat B Drawdown [(B) - (A)]: Feet B	/	For flowing well, measured s	hut in head:feet
Test Pumping Rate:	Gallons Per Minute	Well yielded	GPM with a drawdown of
Duration of Pump Test (minimum 4 hours):	hours	feet after	hours of pumping
I HEREBY CERTIFY that the above statem	710-P	of my knowledge. Signature of Pump	Installer

r

RECEIVED JUL 16 2007 BY: OLWR